


T. 36 S., &
T. 37 S., R. 6 W., W.M.

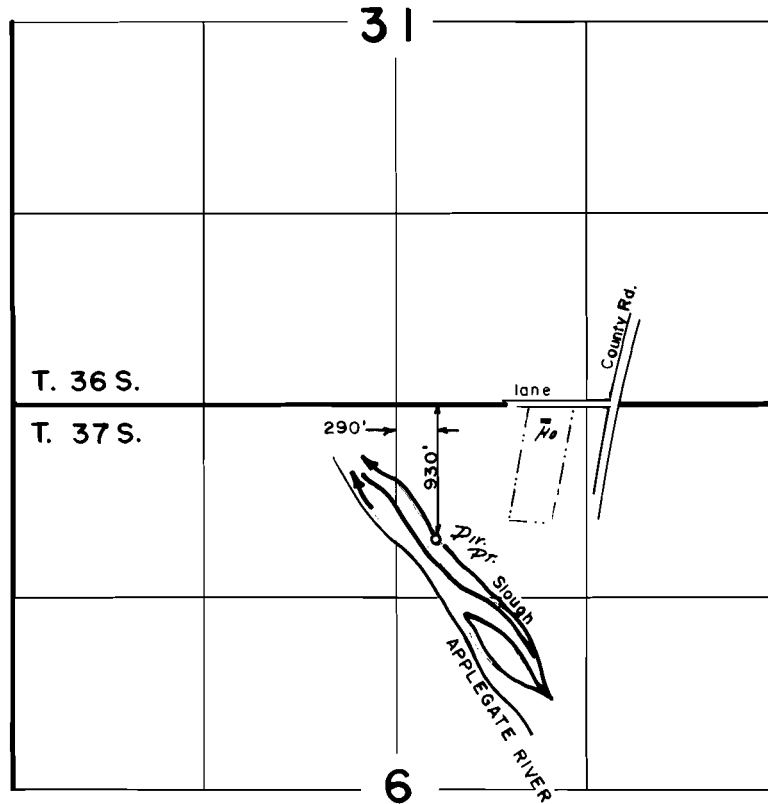

SCALE:
1" = 1320'

FINAL PROOF SURVEY
UNDER

TRANSFER NO. 4811

Application No. 61860 Permit No. 46262

IN NAME OF

Richard D. and Veda I. Connor

Surveyed JUL. 30 1986, by B. S. JAMES