


T.IIS., R.IE., W.M.

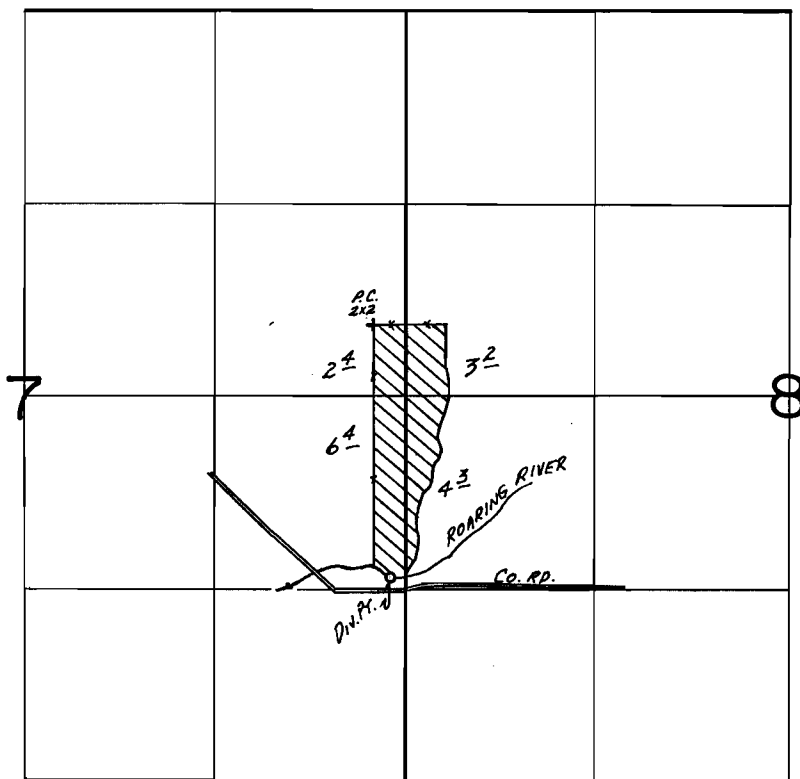

DIV. PT. LOC.: 1250'S. & 120 W. FROM E. 1/4 COR. SEC. 7.

FINAL PROOF SURVEY UNDER

Application No. 53765... Permit No. 40373.....
IN NAME OF

THE BANK OF MONTECITO.....

Surveyed SEPT. 10, 1982., by L.M. TOLL.....