


T.40S.,R.43E.,W.M.

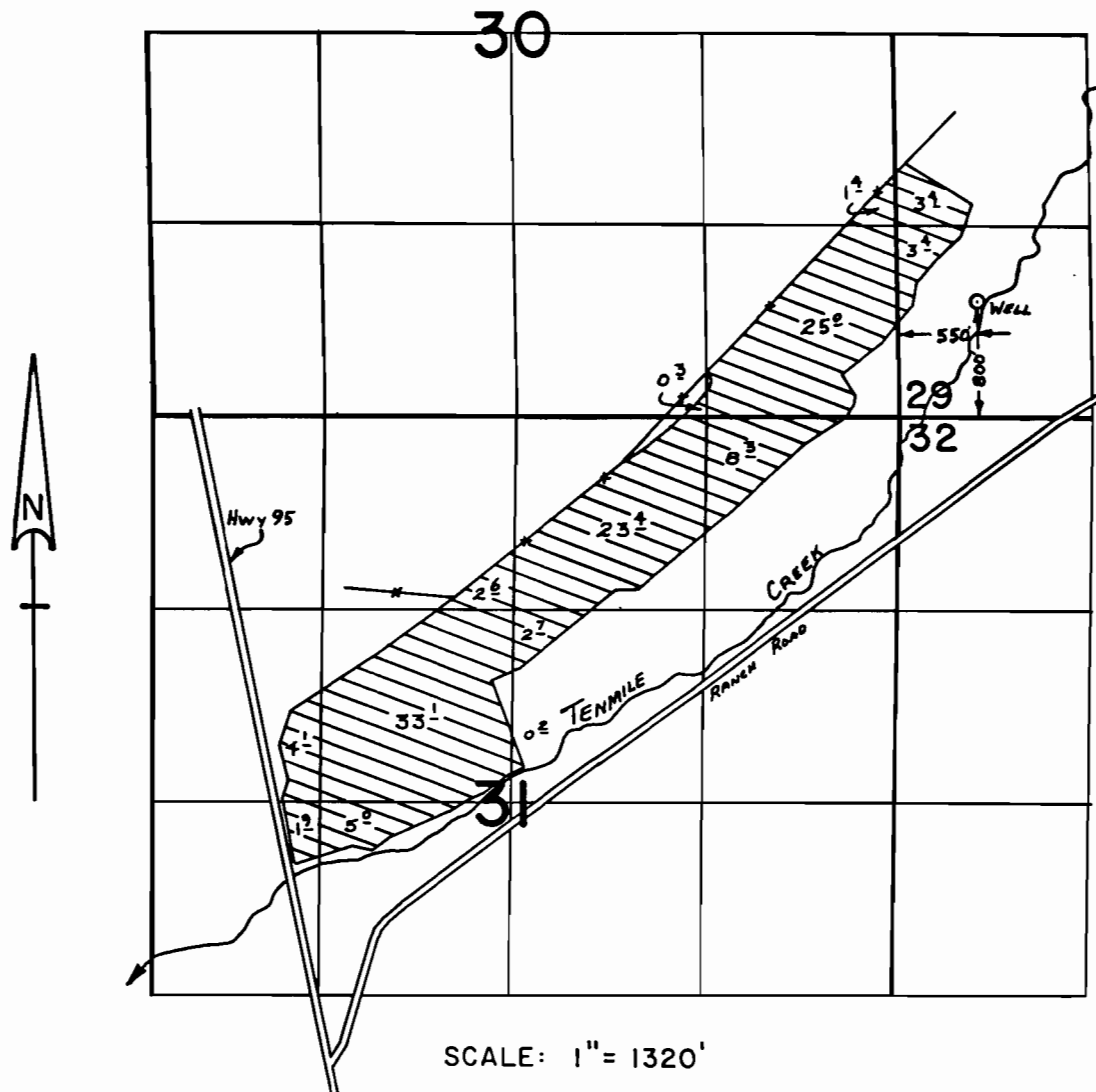

FINAL PROOF SURVEY
UNDER

Application No. G-7432 Permit No. G-8404.....
IN NAME OF

.....W. D. SHERBURN.....

Surveyed July 25, 1985, by L. M. TOLL.....