


T. 40 & 41 S., R. 42 E., W. M.

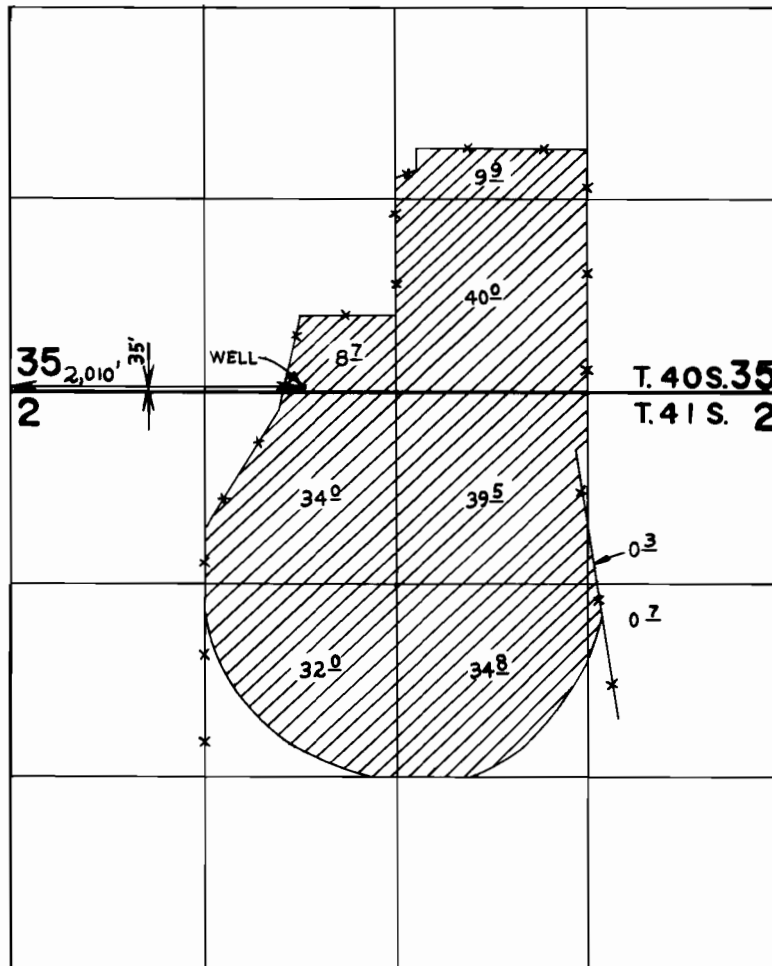

SCALE: 4"=1mile

FINAL PROOF SURVEY UNDER

Application No. G-7937.. Permit No. G-7393.....
IN NAME OF

R.E. NAFTZGER

Surveyed JULY 24, 1985., by L. TOLL.....