


T.6&7S.R.2W. W.M.

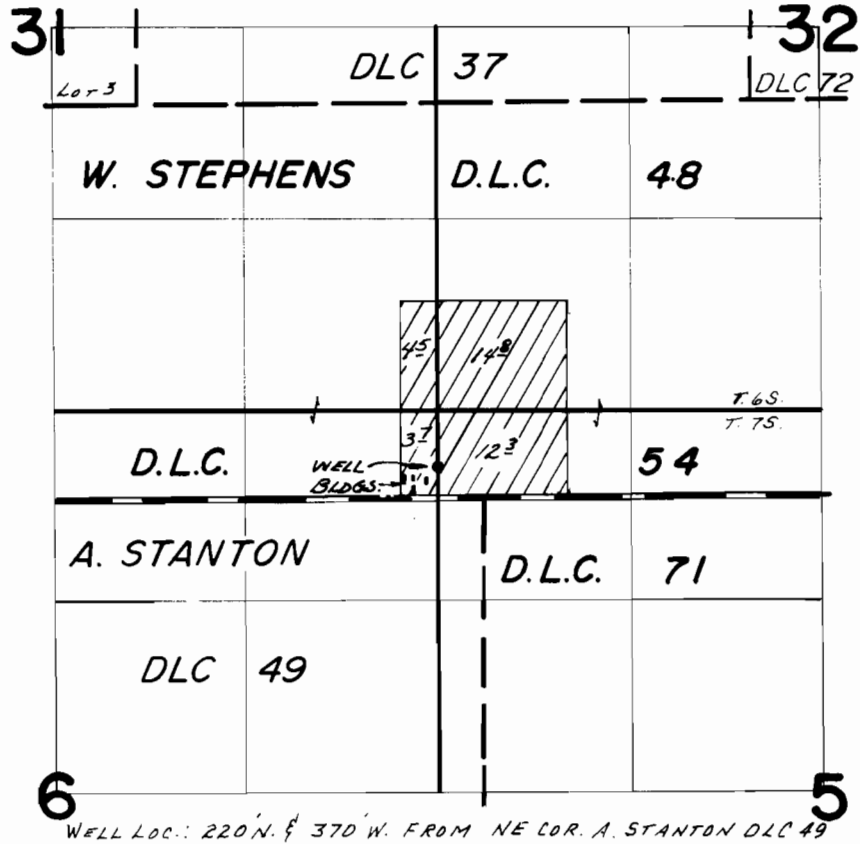

FINAL PROOF SURVEY UNDER

Application No. G-6444 Permit No. G-6046
IN NAME OF

NELTJE SAUCY

Surveyed Oct. 4 1979, by C.R. RODRIGUEZ