


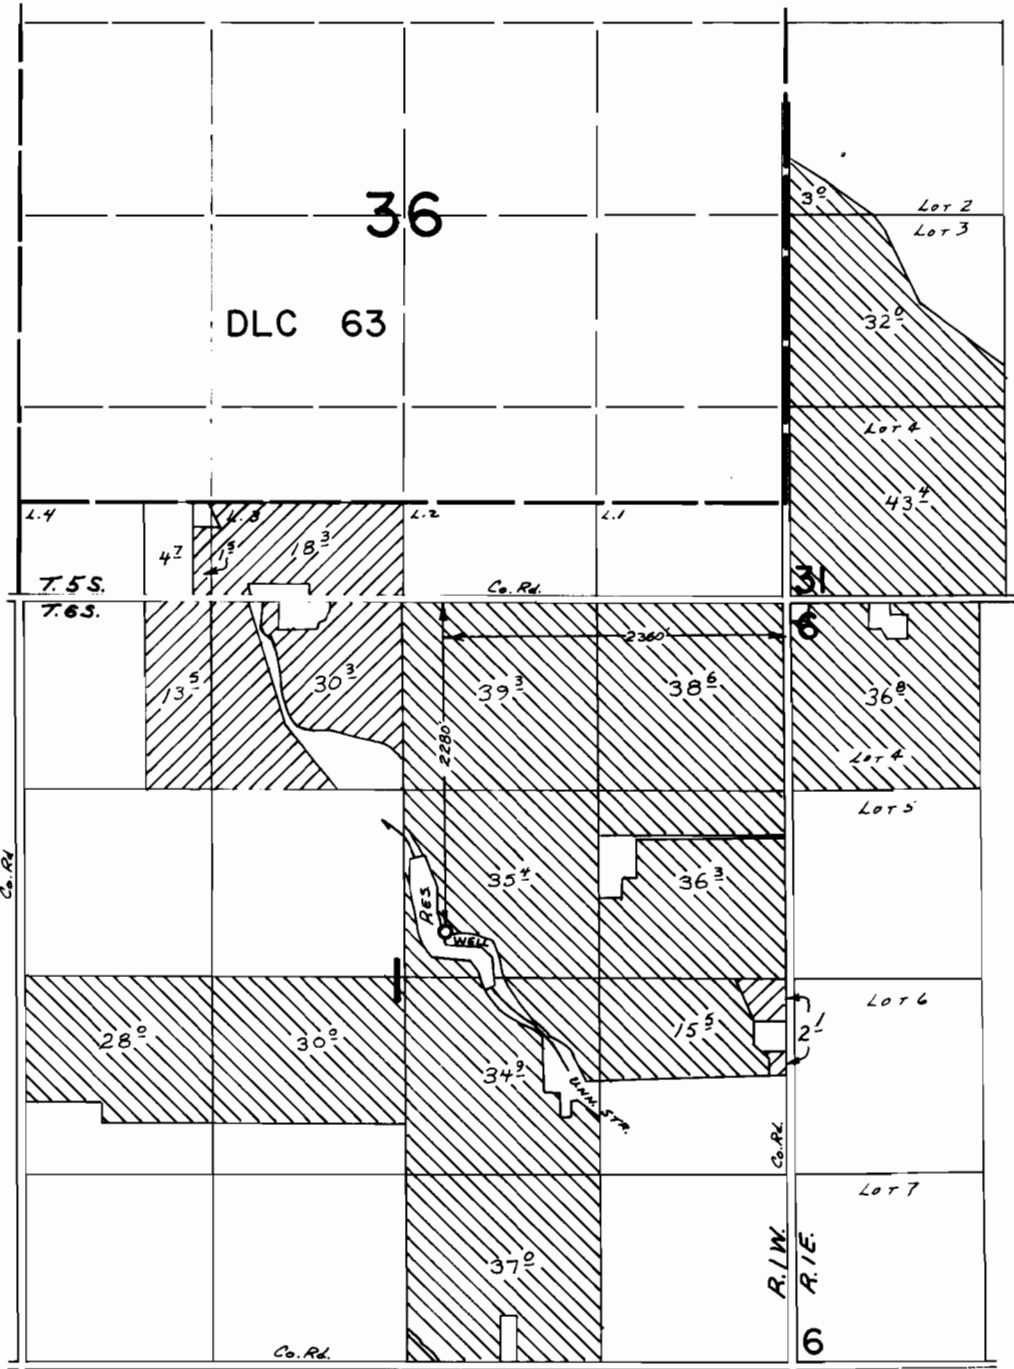

T.5&6S.,R.IW&E.,W.M.



FINAL PROOF SURVEY UNDER

 PRIMARY
 SUPPLEMENTAL

Application No. G-8135. Permit No. G-7508.....
IN NAME OF

JAMES BUTSCH

Surveyed Oct. 14, 1981, by S. C. BROWN.....