


T.6S., R.1E., W.M.

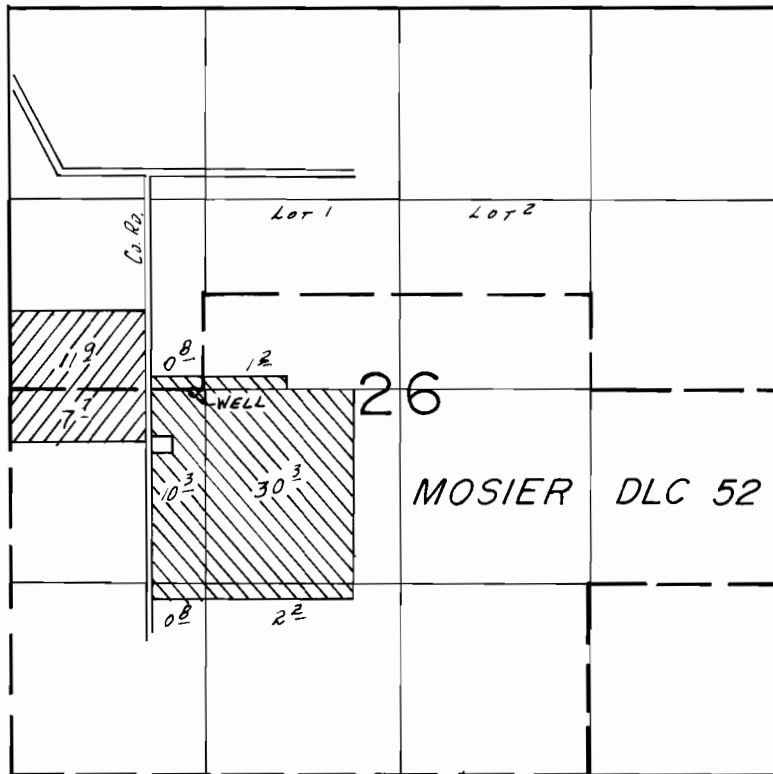

WELL LOC.: 20'S. & 1260'E. FROM W 1/4 COR. SEC. 26.

-  Primary
-  Supplemental

SCALE: 1" = 1320'

FINAL PROOF SURVEY UNDER

Application No. G-9486 Permit No. G-9924....
IN NAME OF

..... JOSEPH H. BIELENBERG

Surveyed Apr. 9.... 19.86., by T.M. WARREN.....