


T.9S. R.3W., W.M.

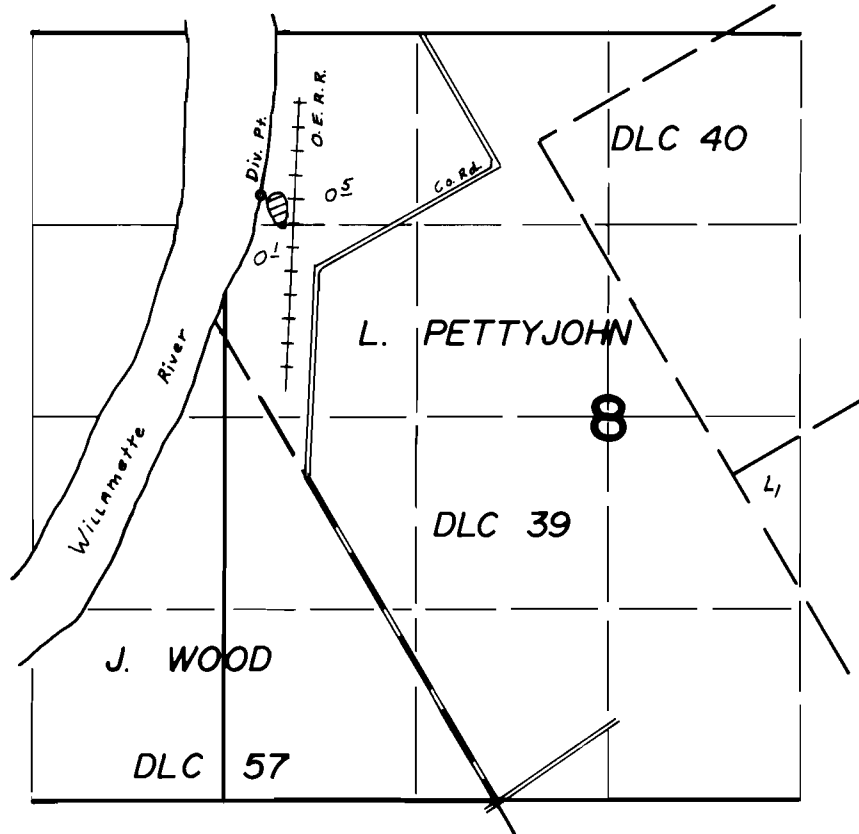

Div. Pt. Loc. 1120' S. & 2390' W. From N. 1/4 Cor. Sec. 8

FINAL PROOF SURVEY UNDER

Application No. 55736... Permit No. 41745.....
IN NAME OF

PORTER W. MAGNESS.....

Surveyed MAY 14 1979, by L. H. NUNN.....