



G 8965  
56446

# T. 2 N. R. 33 E. W. M.

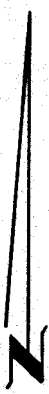

SCALE: 1"=1320'

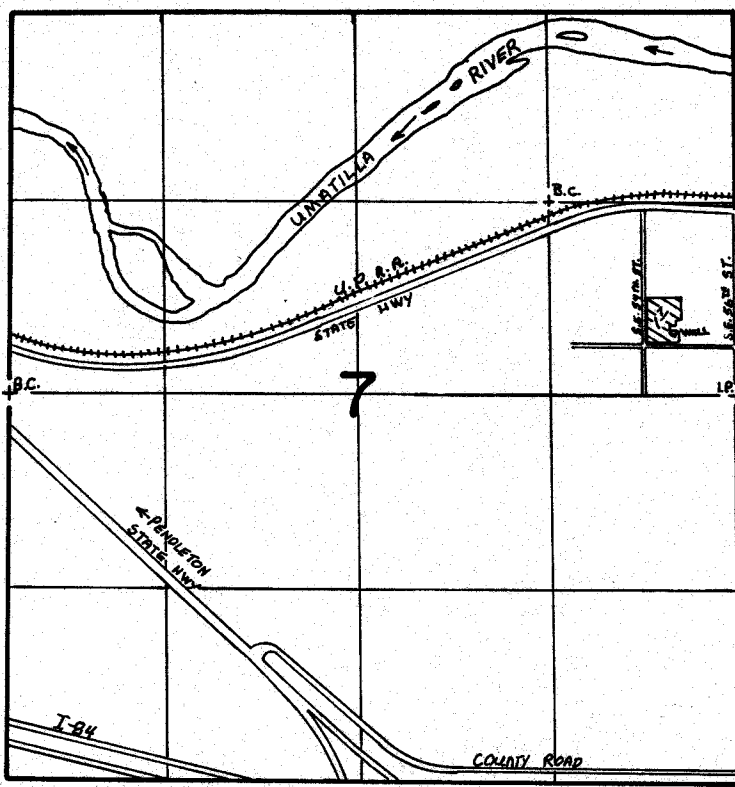

WELL LOCATED 430' N. AND 450' WEST FROM E. 1/4 COR. SEC. 7

## FINAL PROOF SURVEY UNDER

Application No. G-9617. Permit No. G-8965.....  
IN NAME OF

.....**PAUL O. McKEE**.....

Surveyed ....5.8..... 1984., by **V.L. CHURCH**.....