


Application No. 58196
Permit No. 43827

RECEIVED

DEC 22 1978

T2N R12E WM

WATER RESOURCES DEPT.
SALEM, OREGON

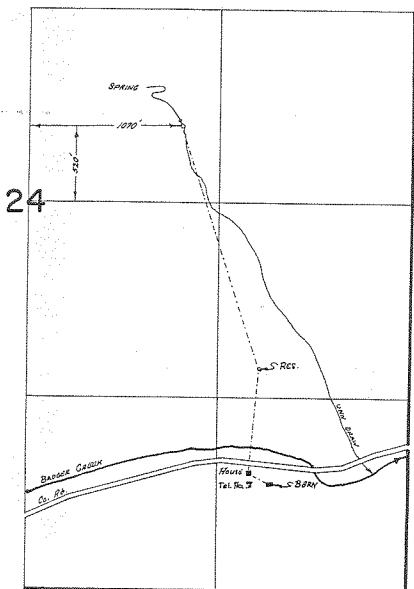

Application Map For
W.R. & Margaret E. Pentecost

8/31/87
TR. Ho. DELETED
FROM RIGHT
AT TIME CERT
ISSUED.

THIS MAP PREPARED BY:

Scale 8" = 1 Mile

[Signature]
FROM INFORMATION FURNISHED BY
THE APPLICANT.