


TOWNSHIP 3 S., RANGE 1 E.

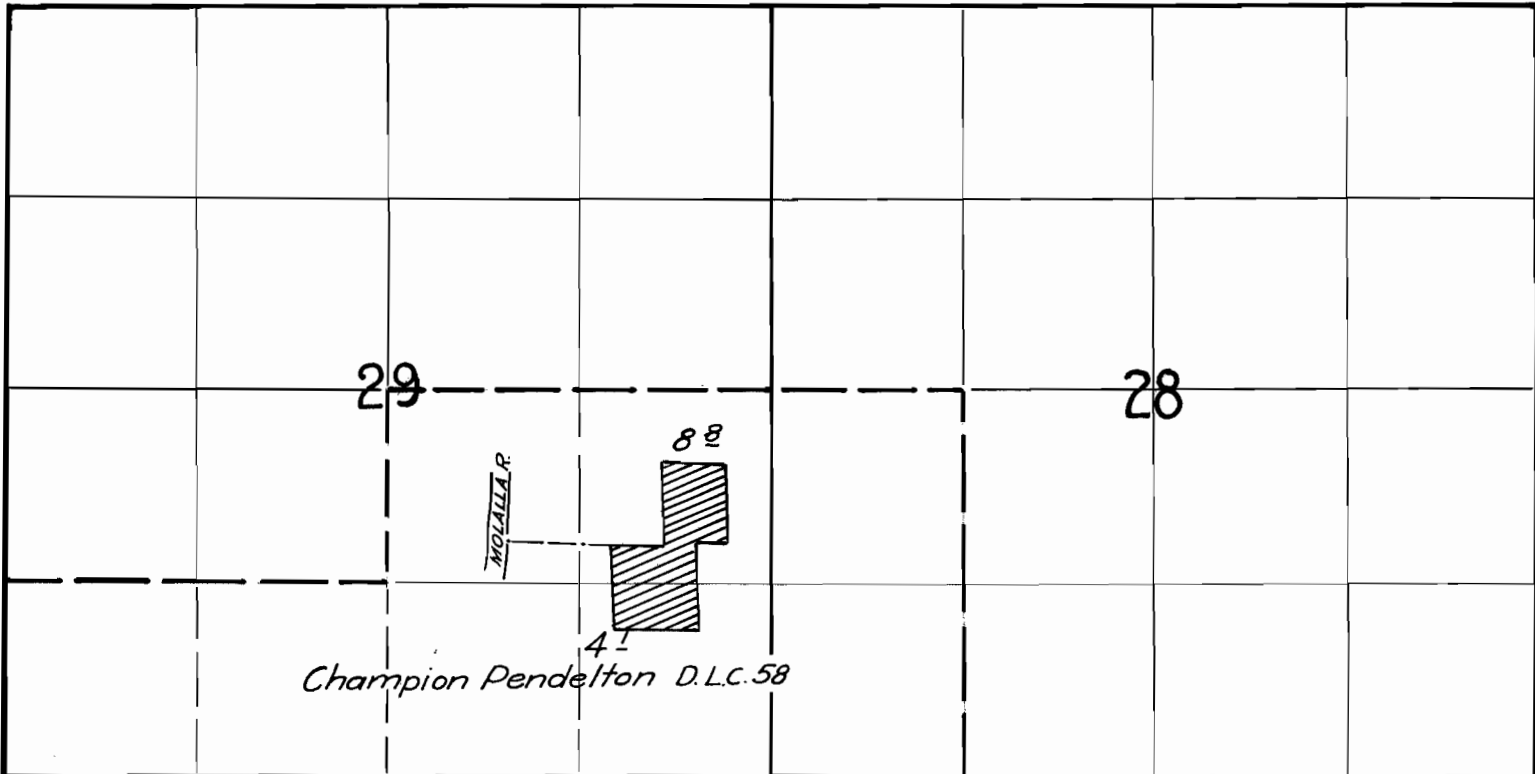

**FINAL PROOF SURVEY**

UNDER

Application No. 18563 Permit No. 14184

IN NAME OF

Arthur W. Miller

Surveyed May 28 1941, by E. C. Cummings