


T.4S.R.1E.W.M.

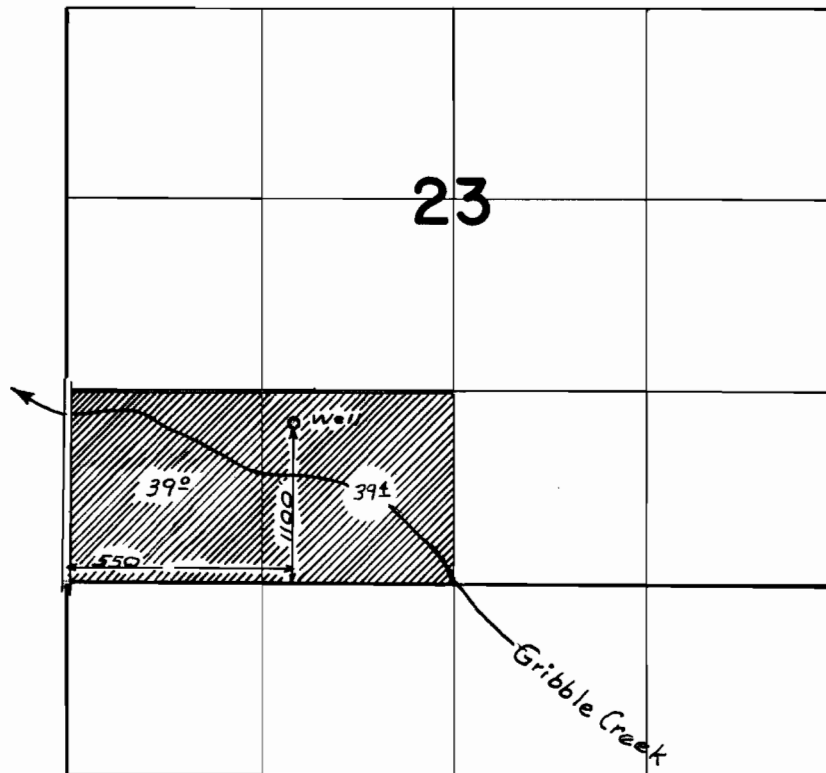

FINAL PROOF SURVEY
UNDER

Application No. G-2722 Permit No. G-2532
IN NAME OF

Orlin R. Bevier

Surveyed Oct. 17 1967, by W. J. Ruppert