


T. 25 S. R. 7 W. W.M.

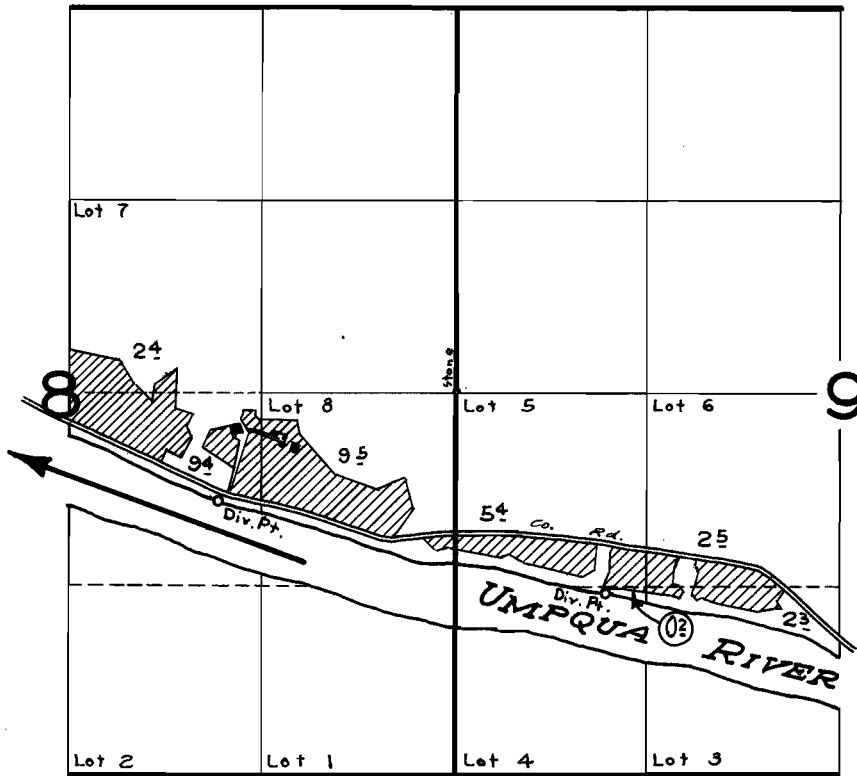

FINAL PROOF SURVEY
UNDER

Application No. 29395 Permit No. 23154
IN NAME OF

JOHN J. THENNES

Surveyed March 31 1961, by R. Jackson