


T.13S., R.28E., W.M.

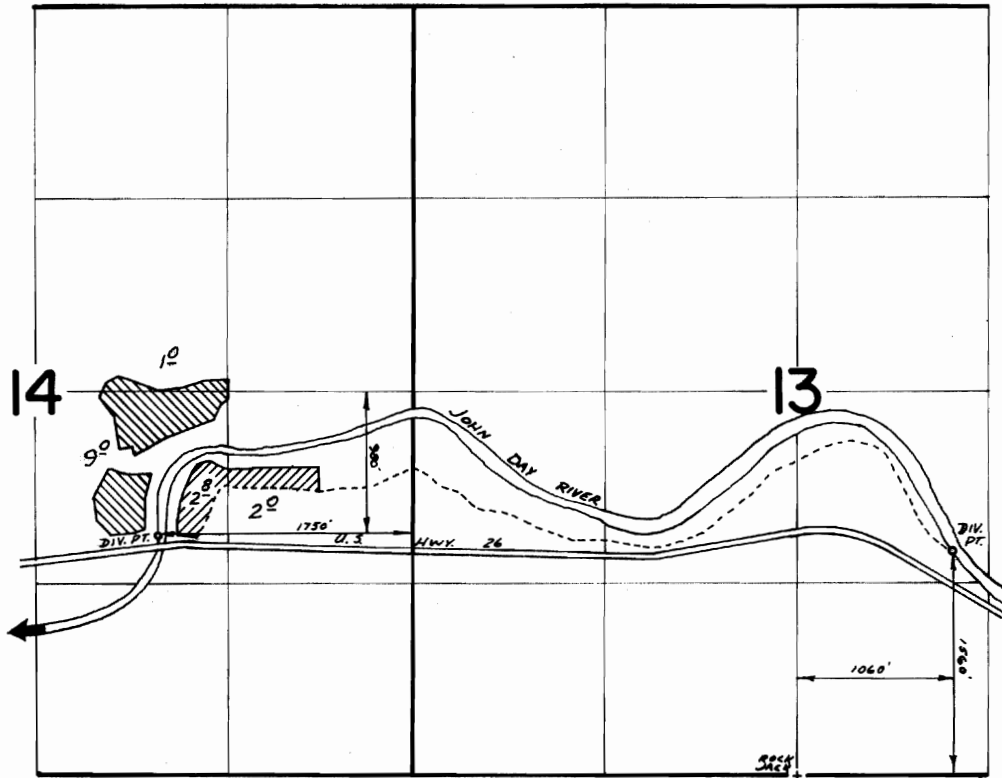

FINAL PROOF SURVEY
UNDER

Application No. 42491 Permit No. 31774
47039 35184 
IN NAME OF

HANS C. & MARY B. ESKILDSON

Surveyed June 21 1975, by D. Norby