


T. 12S., R. 34E., W.M.

~~T-3931~~
P. 40104
56577
56529
56477

SCALE 1" = 1320'

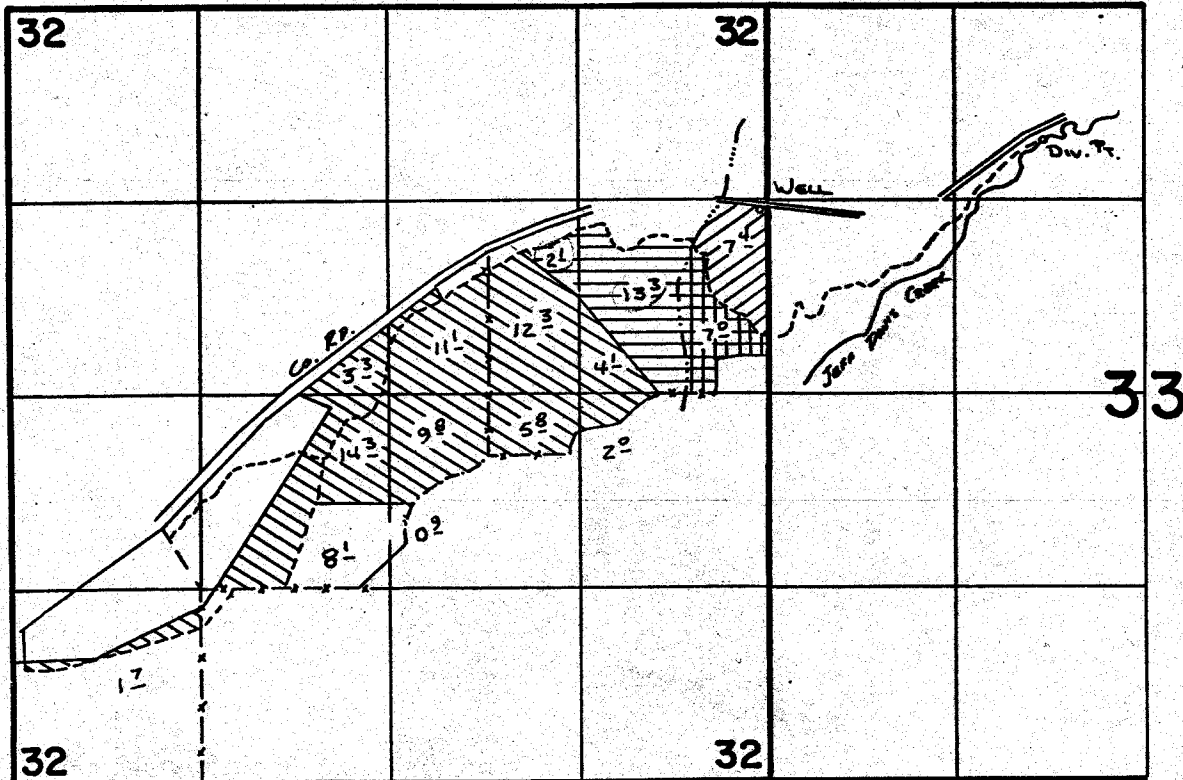

Div. Pt. Loc: 910'S. & 1940'E }
Well Loc: 1390'S. & 50'W. } FROM NE COR SEC 32

FINAL PROOF SURVEY UNDER

TRANSFER 3931

53711

40104

Application No. G-7136 Permit No. G-6586
IN NAME OF

DOROTHY BLASING

Surveyed 3-18-1986, by L. T. T. T.

-  PRIM PER. 40104
-  T-3931
-  PRIM PER. G-6586
-  SUPPL PER. G-6586