


# T. 41S., R. 3W., W.M.

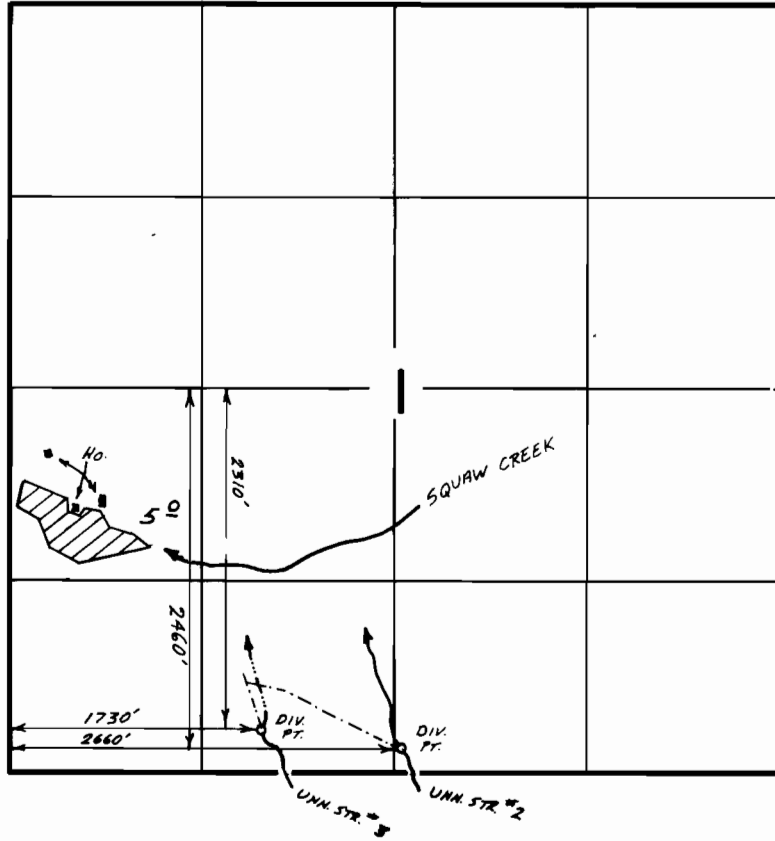

Scale 1"=1320'

## FINAL PROOF SURVEY UNDER

Application No. 54746. Permit No. 41069.....  
IN NAME OF

.....A.C. PIERCE.....

Surveyed Sept. 25, 1985, by B.S. JAMES.....