


T.41S., R.2W., W.M.

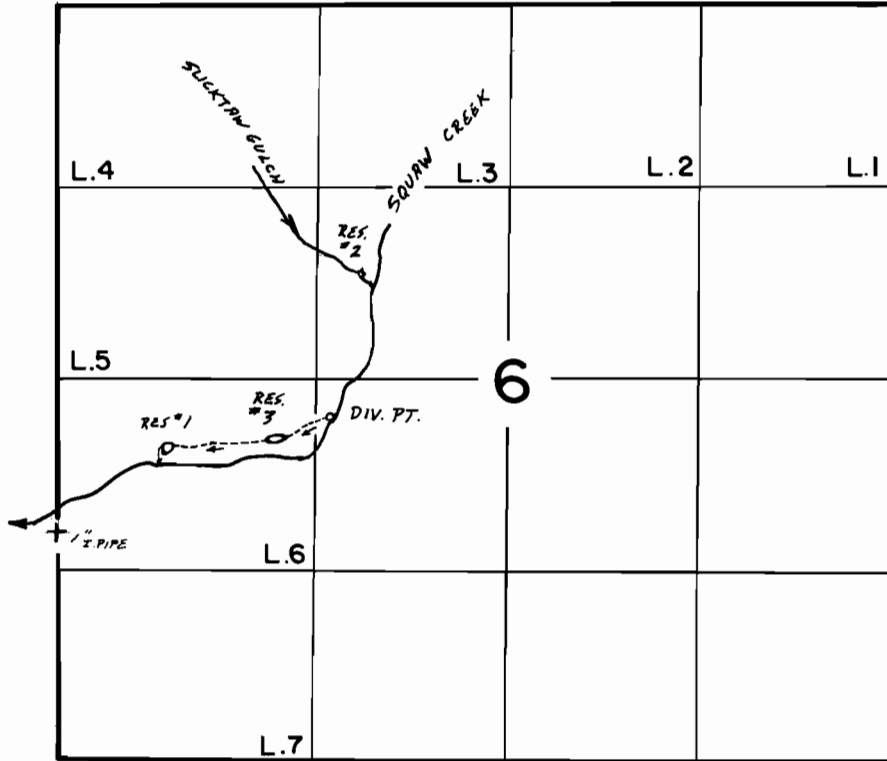

DIV. PT.: 250' S & 1850' E FROM W 1/4 COR. SEC. 6.
 RESERVOIR #1: 470' S & 700' E " " " "
 " #2: 700' N & 2000' E " " " "
 " #3: 430' S & 1400' E " " " "

Scale 1"=1320'

FINAL PROOF SURVEY

UNDER

R-57031 R-7254
 57032 43053
 R-60083 R-8234

Application No. 60084 Permit No. 45532....

IN NAME OF

.....ARCHIE C. PIERCE.....

Surveyed Sept. 25, 1985, by B.S. JAMES.....