


T. 41 S., R. 1 E., W. M.

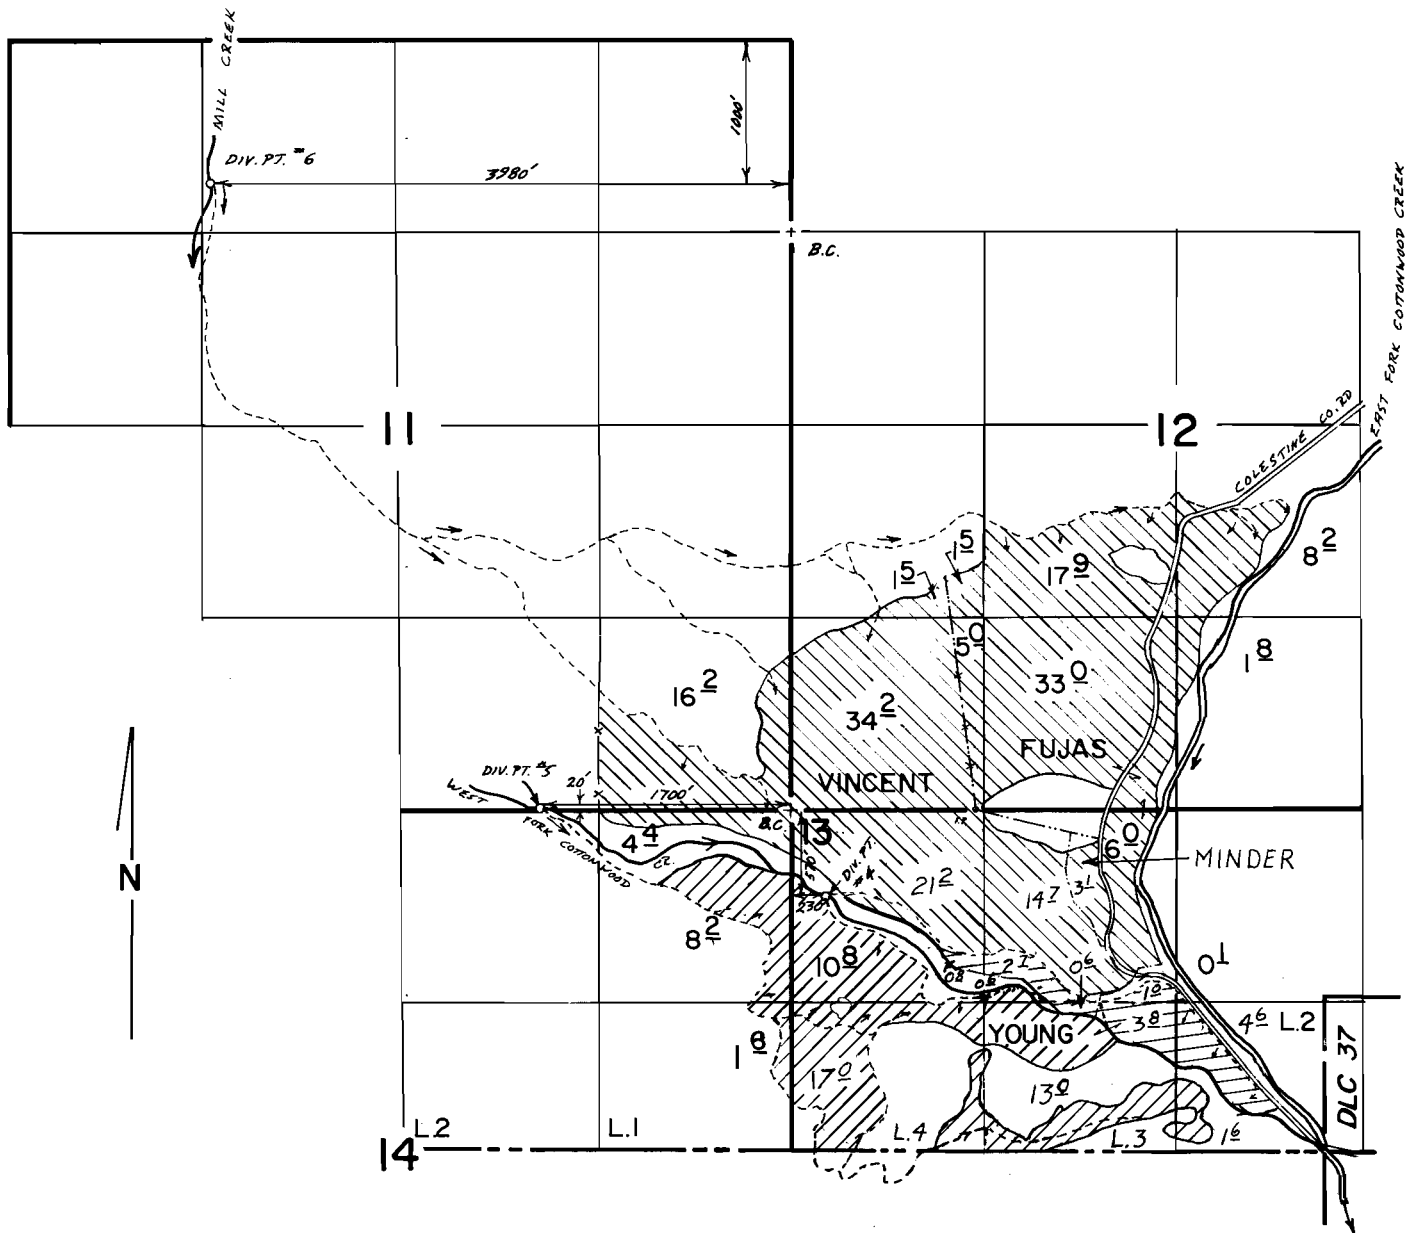

- DIV. PT. 4
 DIV. PT. 5
 DIV. PT. 6

Scale 1" = 1320'


FINAL PROOF SURVEY

UNDER

Application No. 58955. Permit No. 44755.....
IN NAME OF

MINDER, YOUNG, VINCENT, & FUJAS.....

Surveyed Sept. 12, 18, 1985, by B.S. JAMES.....

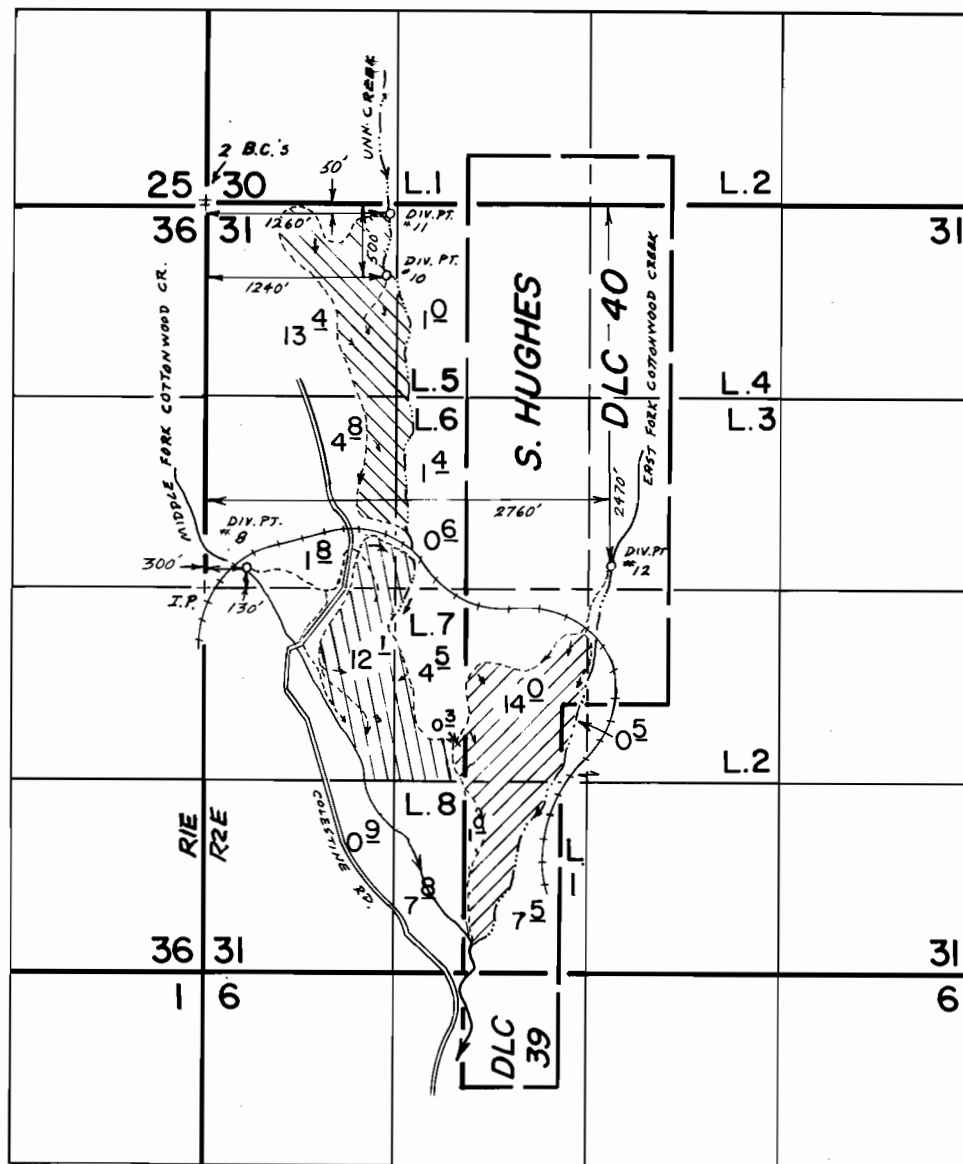

FINAL PROOF SURVEY

UNDER

Surveyed Sept. 12, 18, 19 85, by B.S. JAMES.....