


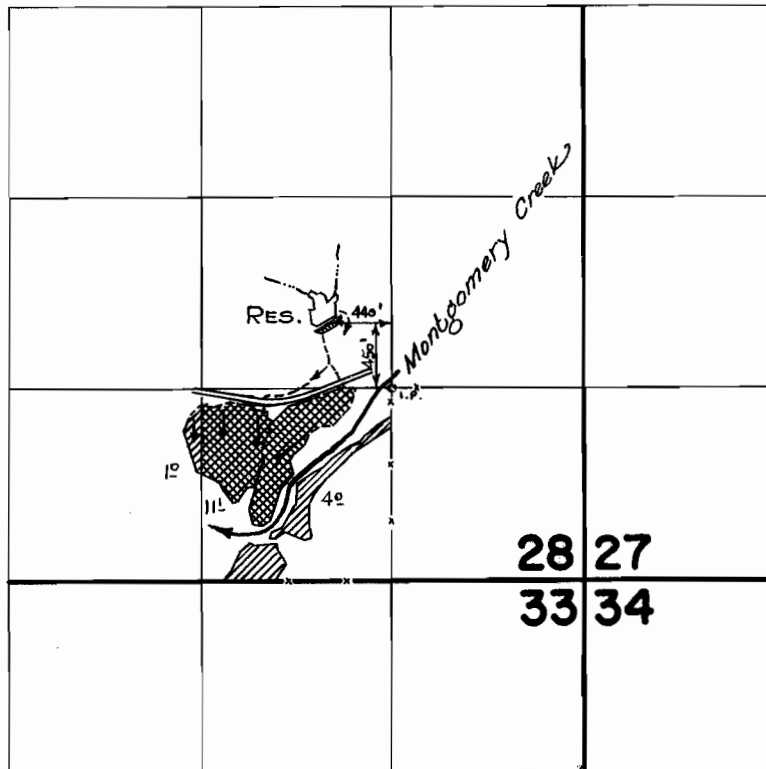

# T.38S.R.8W.W.M.



 PRIMARY  
 SUPPLEMENTAL

## FINAL PROOF SURVEY UNDER

R-37741                      R-3085  
Application No. 37742    Permit No. 28189  
IN NAME OF

TRIANGLE 3 RANCH

Surveyed June 23 1965, by *[Signature]*