


~~75472~~
G-1388
C# 56503
Transfer# 5412
51863

T.30S.,R.16E.,W.M.

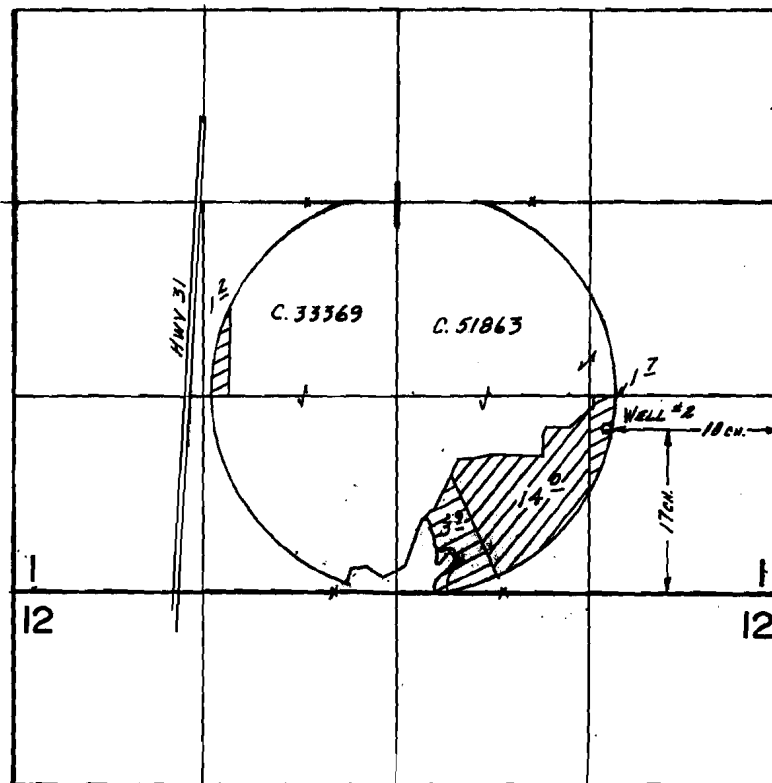

Tr. 5412
G-11199

SCALE: 1" = 1320

FINAL PROOF SURVEY
UNDER

Transfer No. 5412
Application No. G-11199 Permit No. G-10293...
IN NAME OF

..... WITHERS RANCH, INC.

Surveyed Oct. 14, 1985, by B.W. BISHOP.....