


T. 6 S. R. 2 W. W. M.

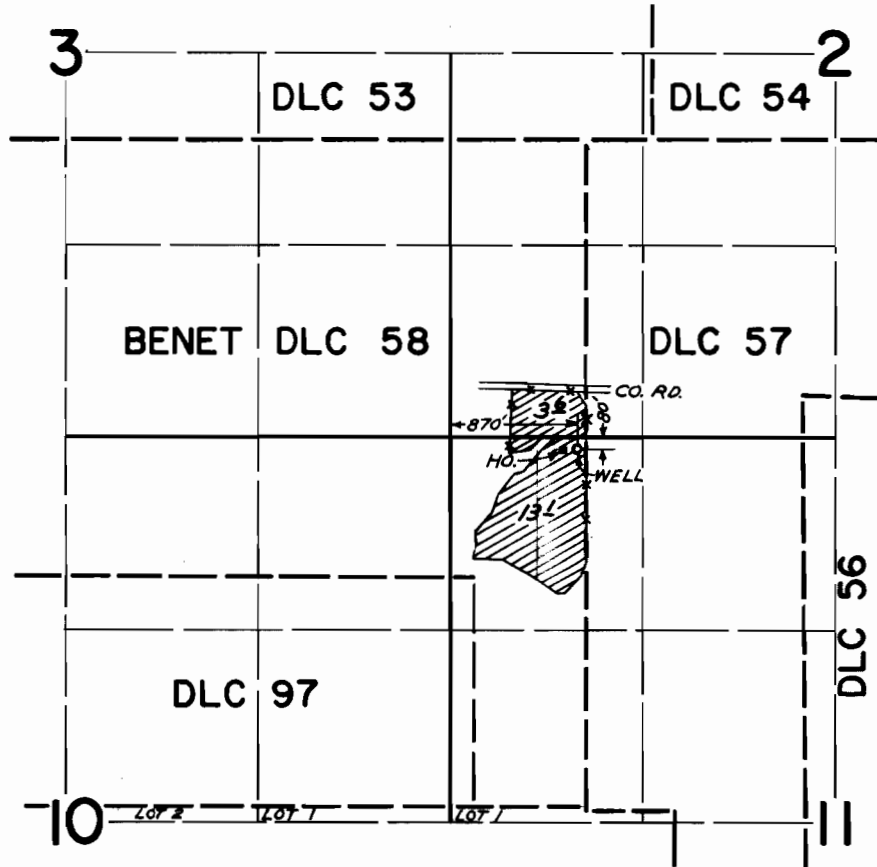

**FINAL PROOF SURVEY**  
UNDER

Application No. G-3621 Permit No. G-3404  
IN NAME OF

ALICE BARNETT

Surveyed JULY 7 1971, by GREG BACA