


T.9S. R.6W.W.M.

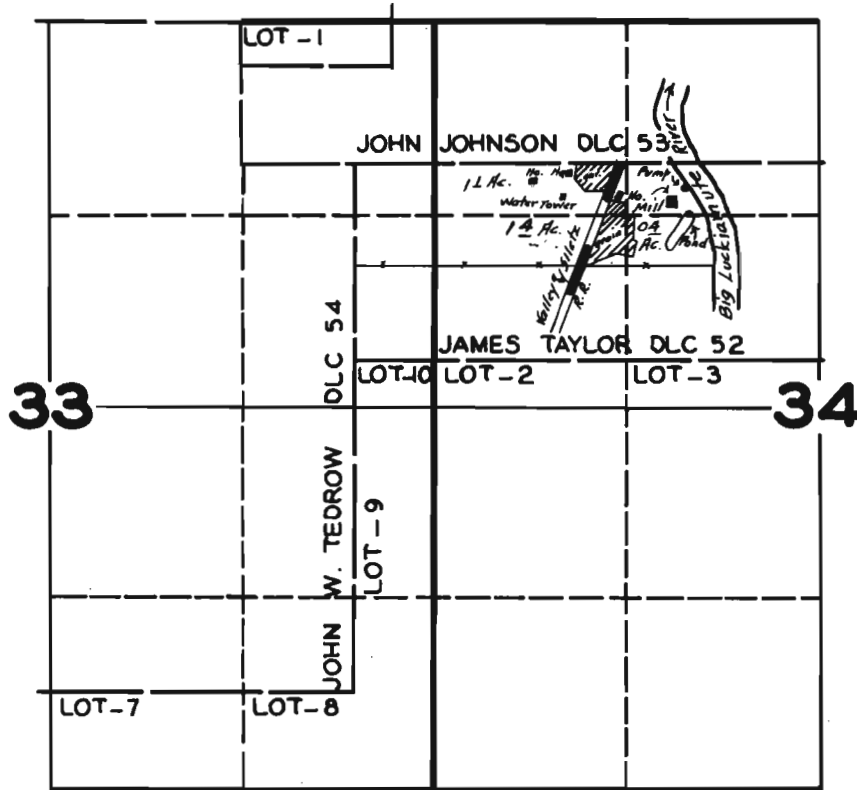

FINAL PROOF SURVEY UNDER

Application No. 18299 Permit No. 13945

IN NAME OF

VAN DEN BOSCH LUMBER CO.

Surveyed AUG. 18, 1944, *Frank O. [Signature]*