



T. 6 N. R. 35 E. W.M.

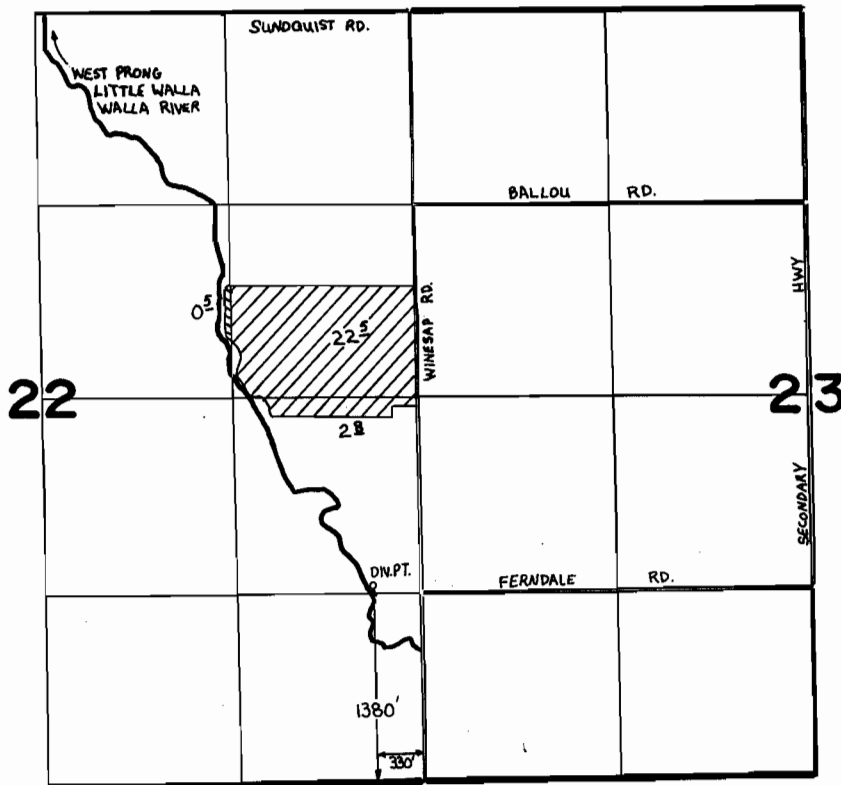

Scale 1" = 1320'



 - Primary

 - Supplemental

FINAL PROOF SURVEY UNDER

Application No. 64920. Permit No. 47715.....
IN NAME OF

LOWELL M. EIFFERT

Surveyed May 9, 1986, by J. Sauter.....