


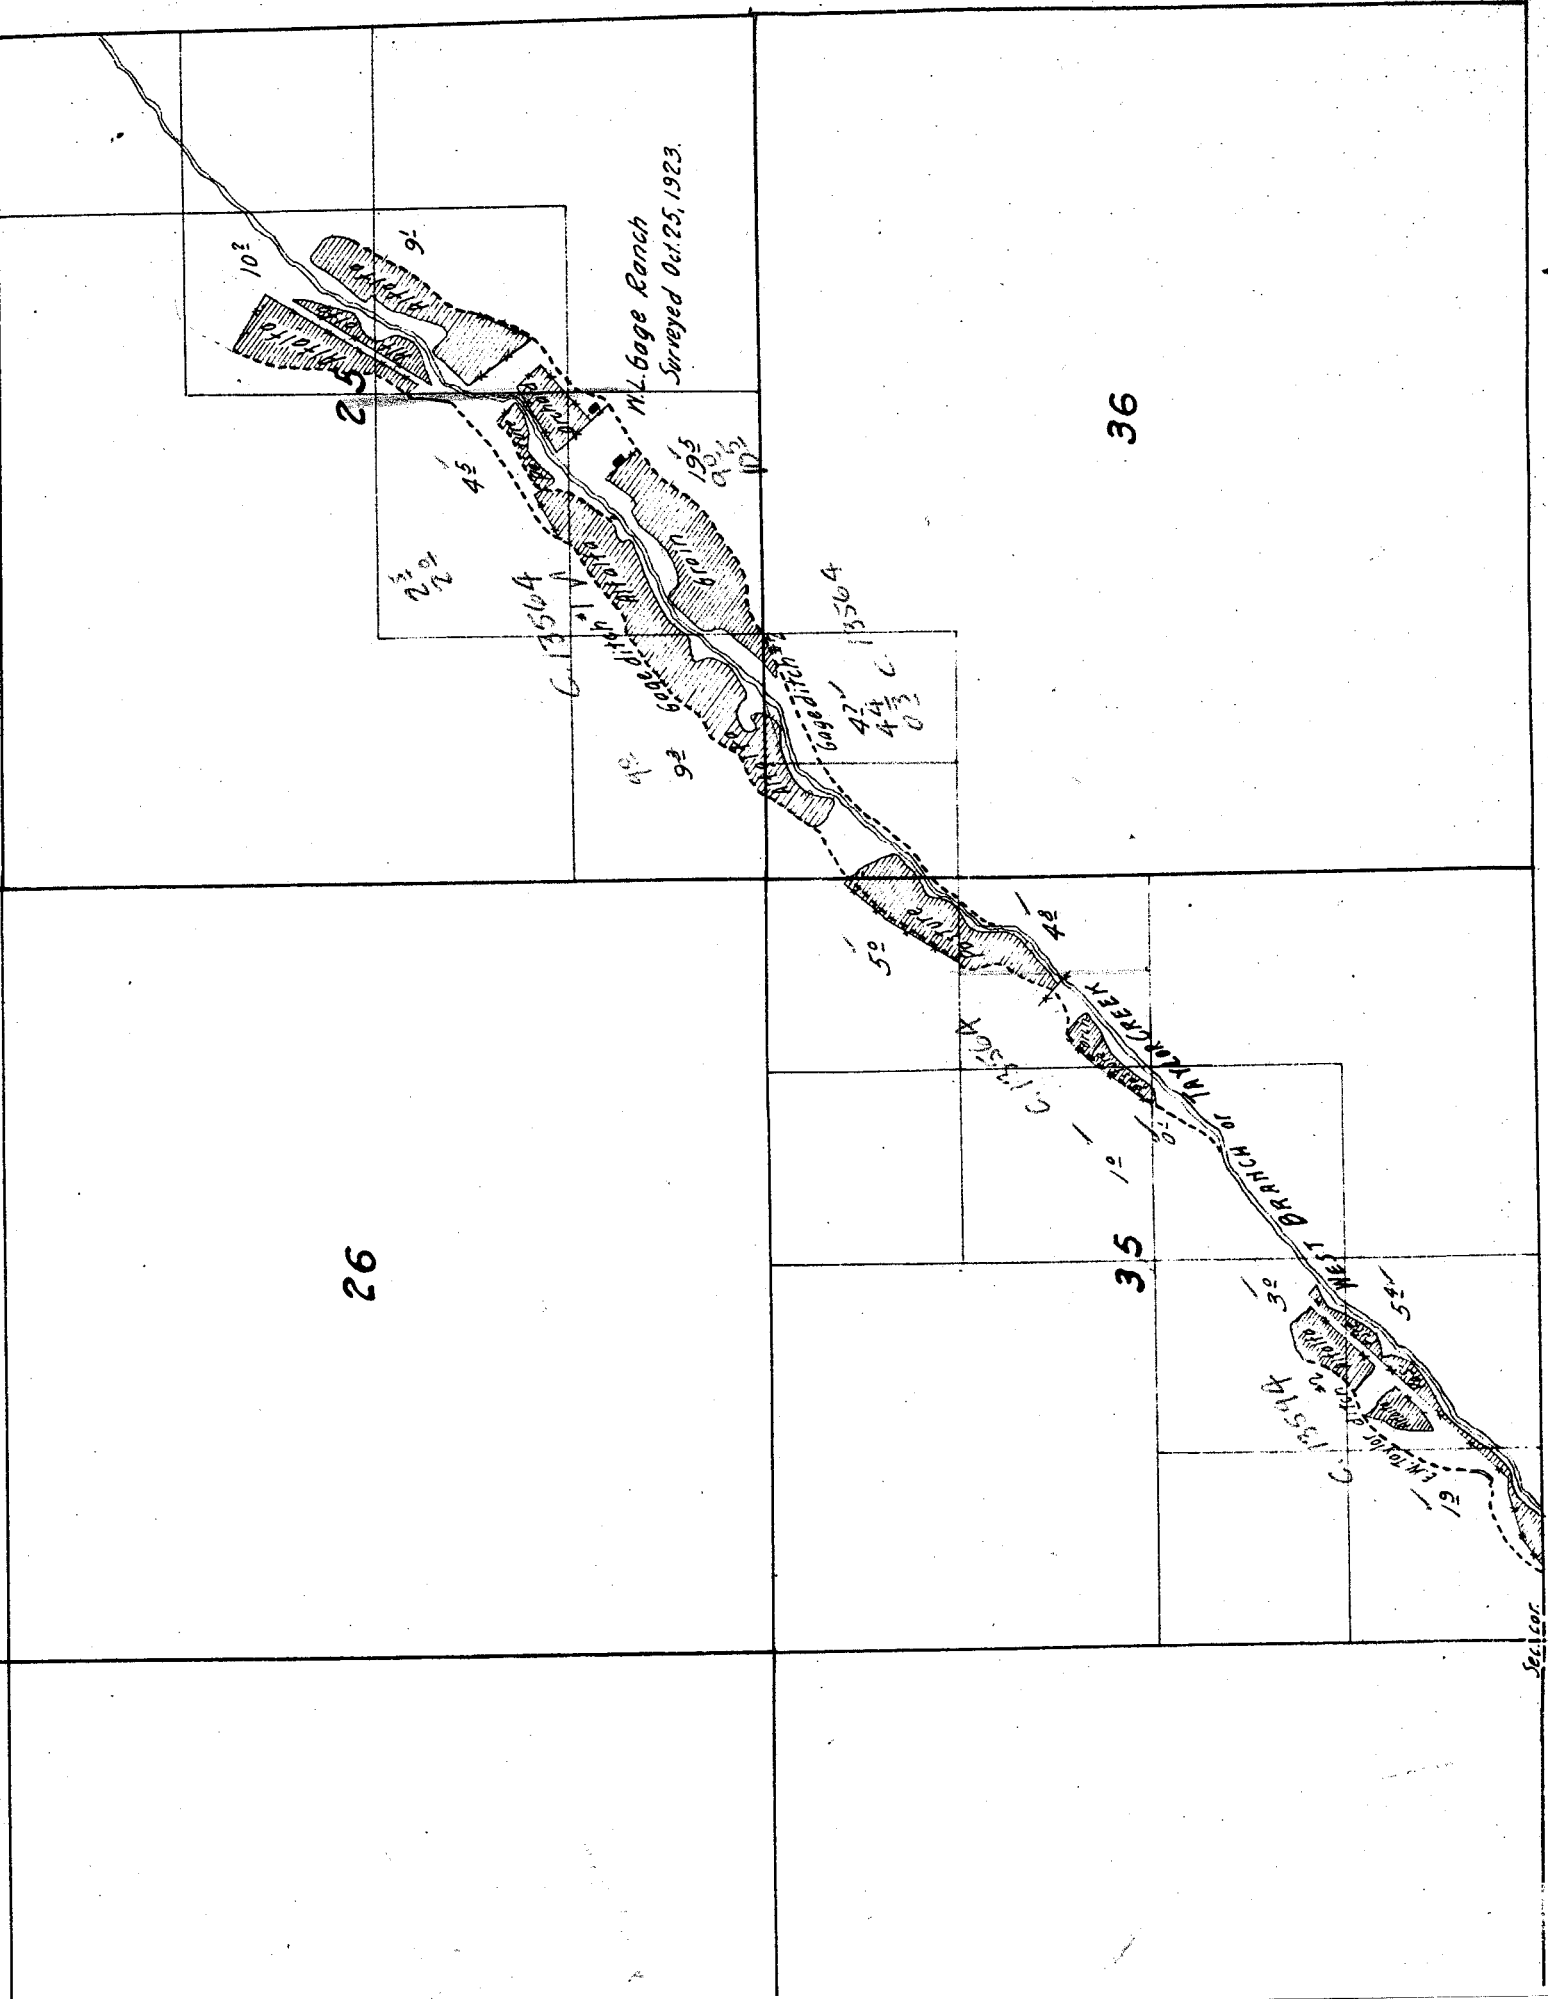

8021 100

		13	
			24
		14	
			23

34

33

27

28

22

21

15/12/56

17

81

8

7

5

9

14

13

11

12

2

1

Township

11 S,

Range


20 E.


4

3

*Note: Bear Creek partly sketched
in approximate location from
U.S. Township plat.*

10

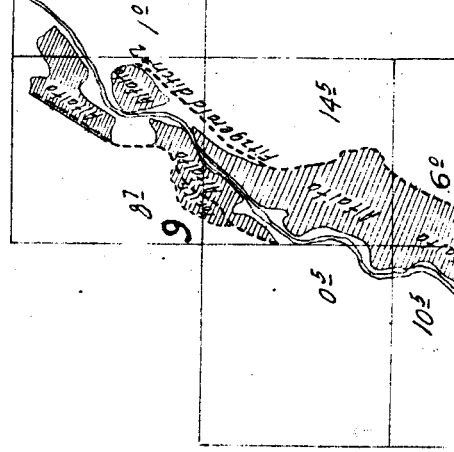

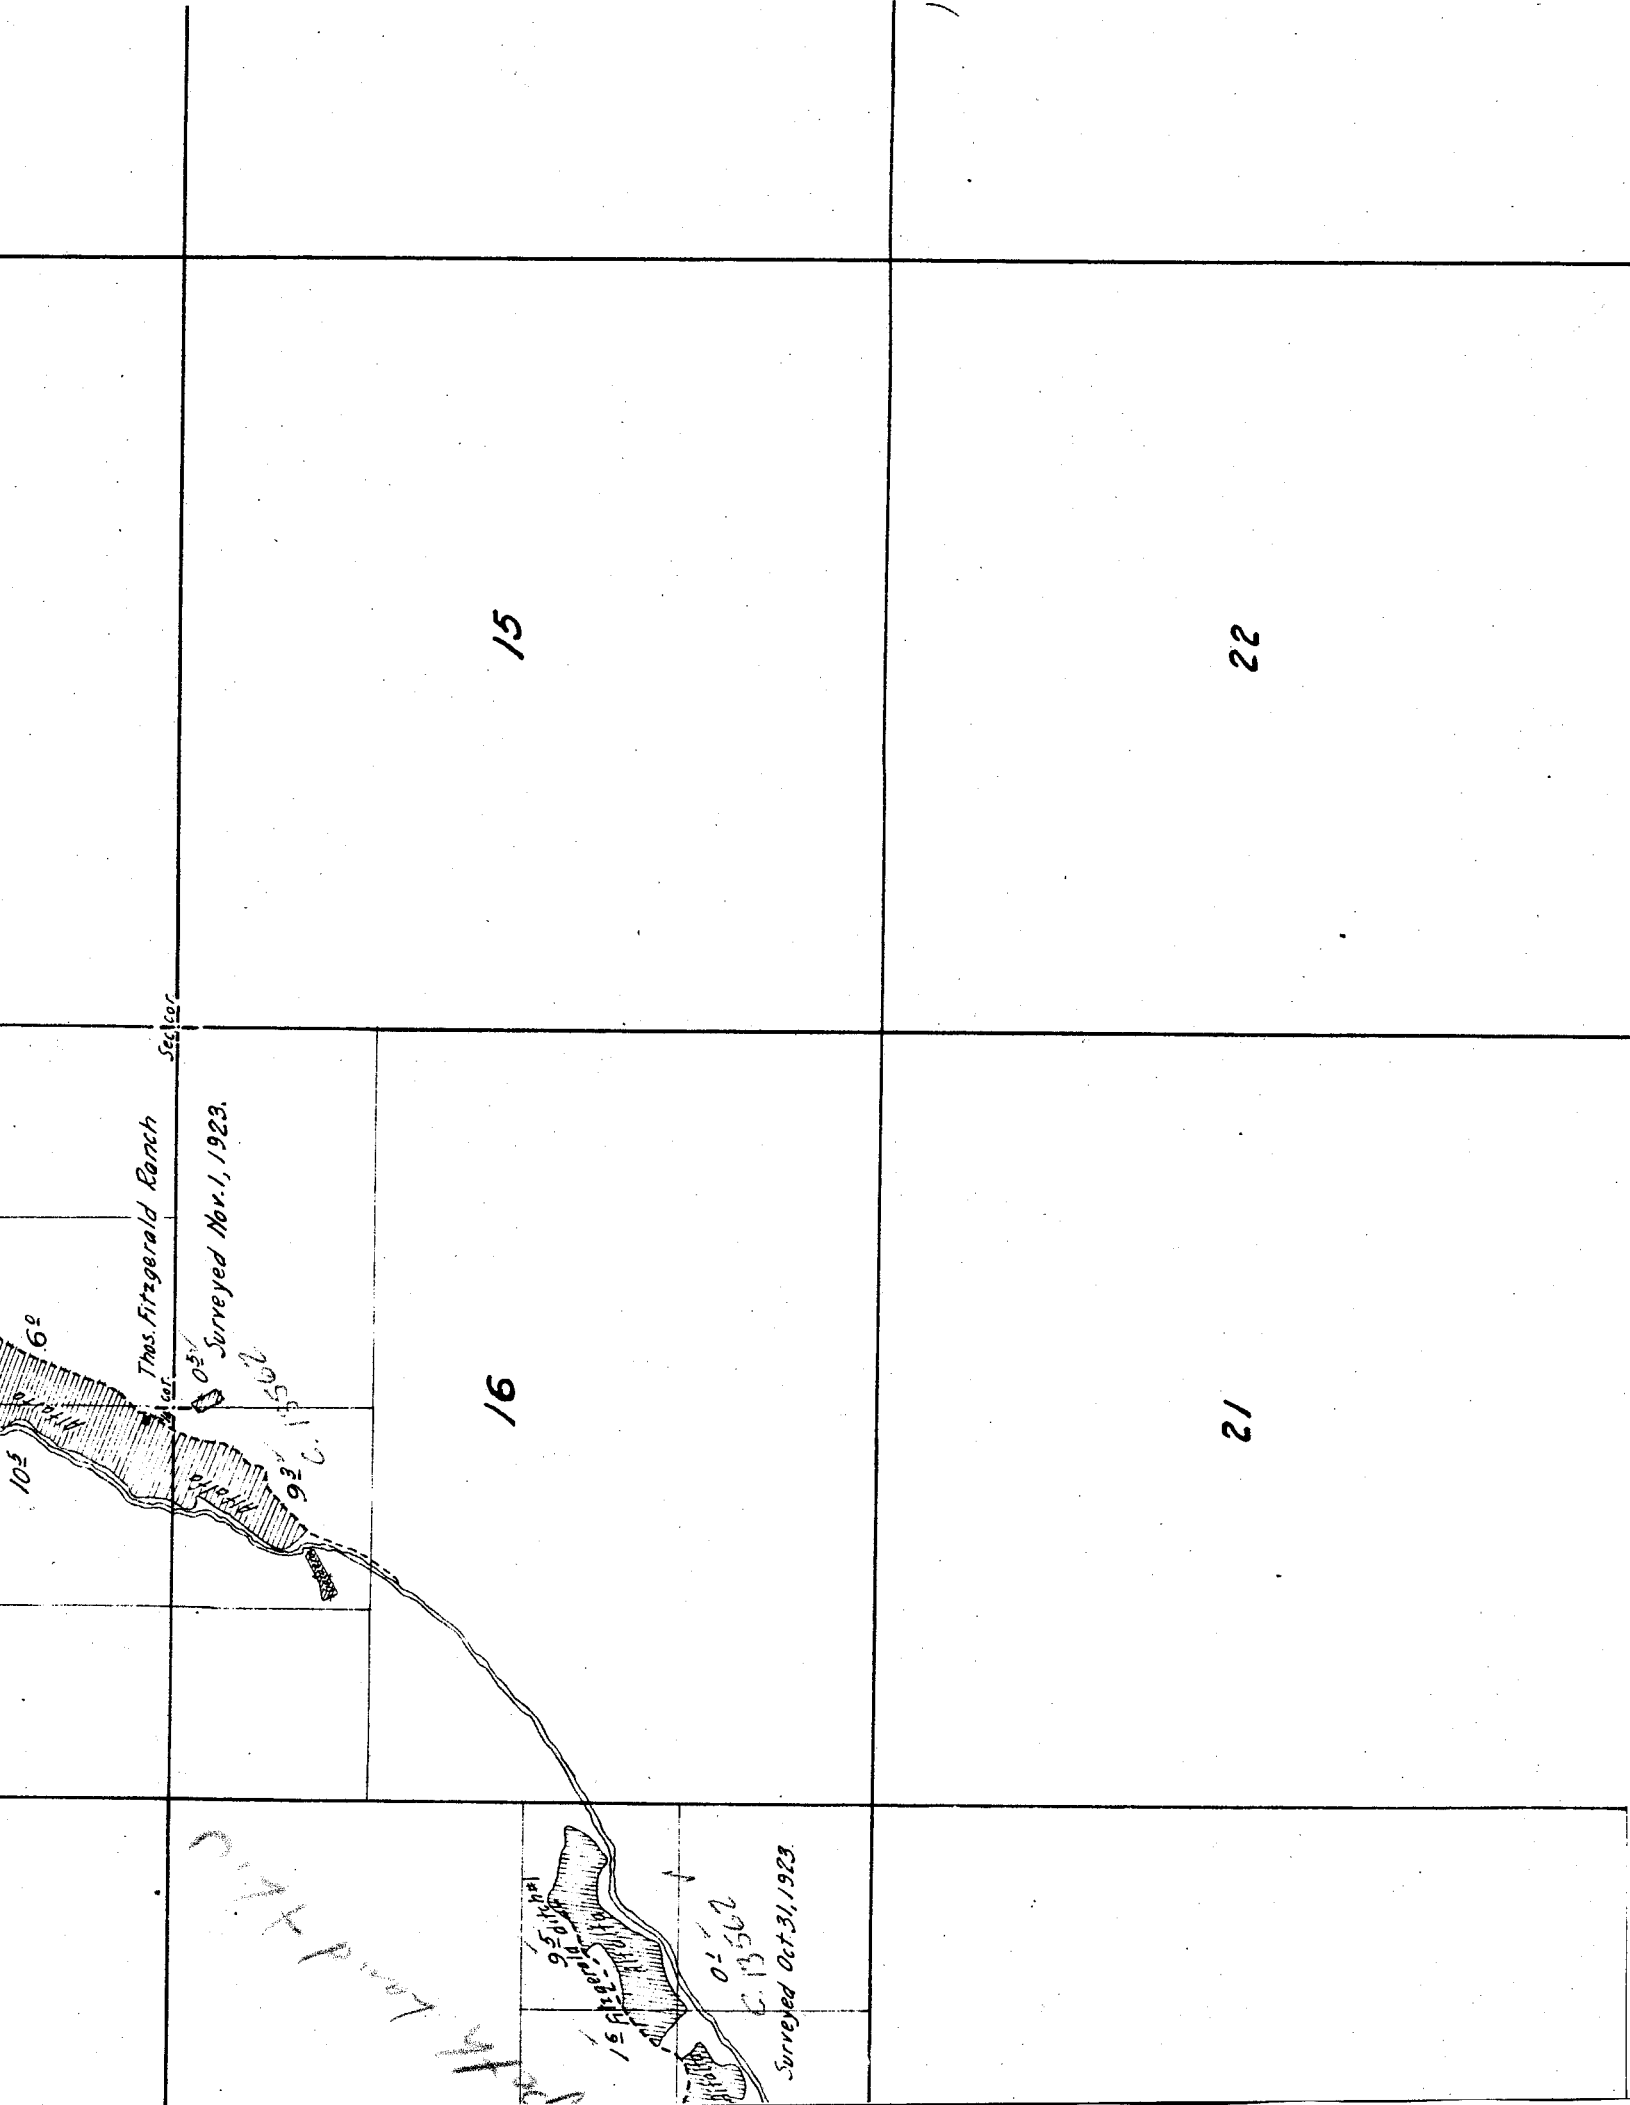


15

22

16

12

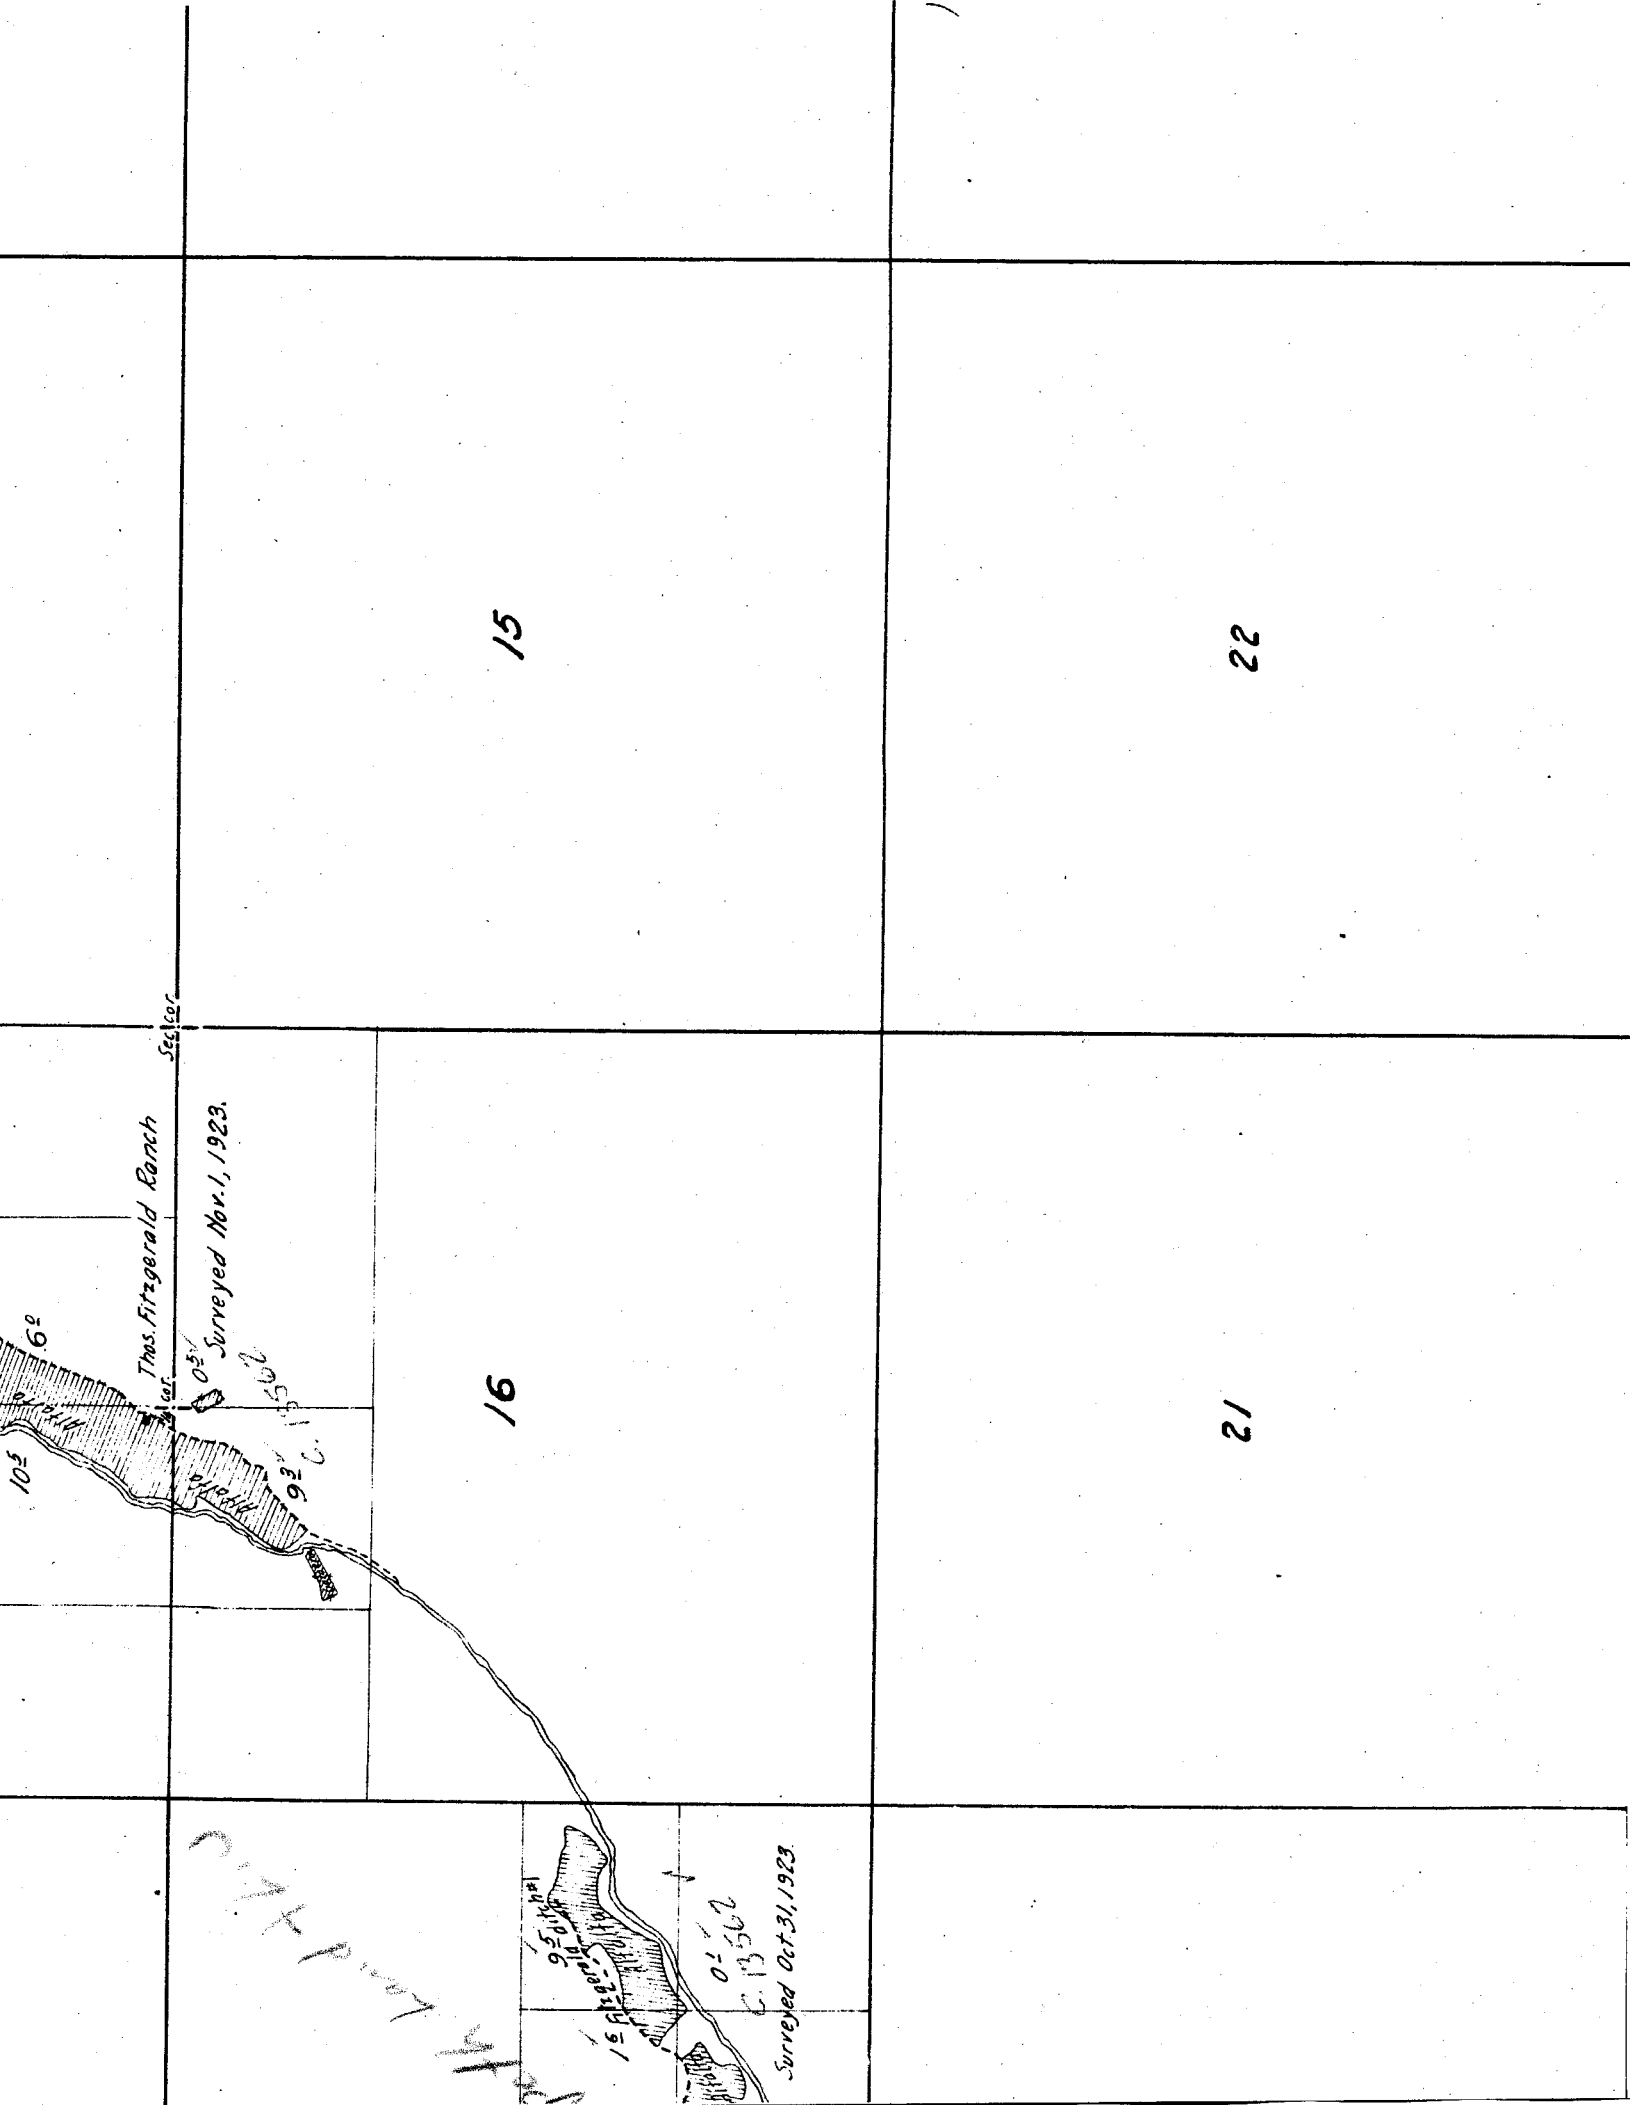

15

22

16

12




16

12

Handwritten text: "H. L. Land + A. C."

17

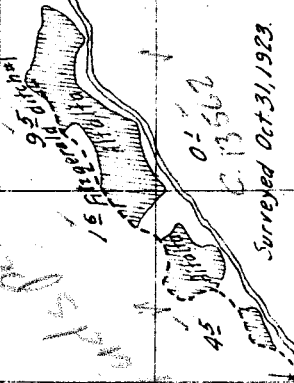

20

BEAR CREEK

18

19


Handwritten text: "Johnson"



Mary E. Stephenson Ranch

Surveyed Oct 31, 1923

Surveyed Oct. 19, 1923

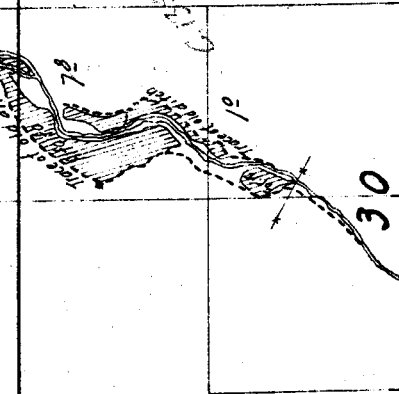

28


29

30

33

32

31

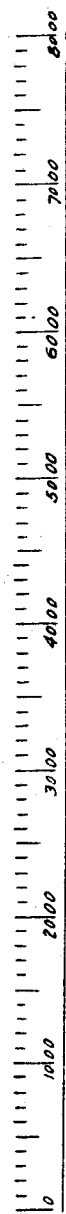

Scale of Feet