


T.38S., R.4 W., W.M.

Sec. 25

NW 1/4 NE 1/4

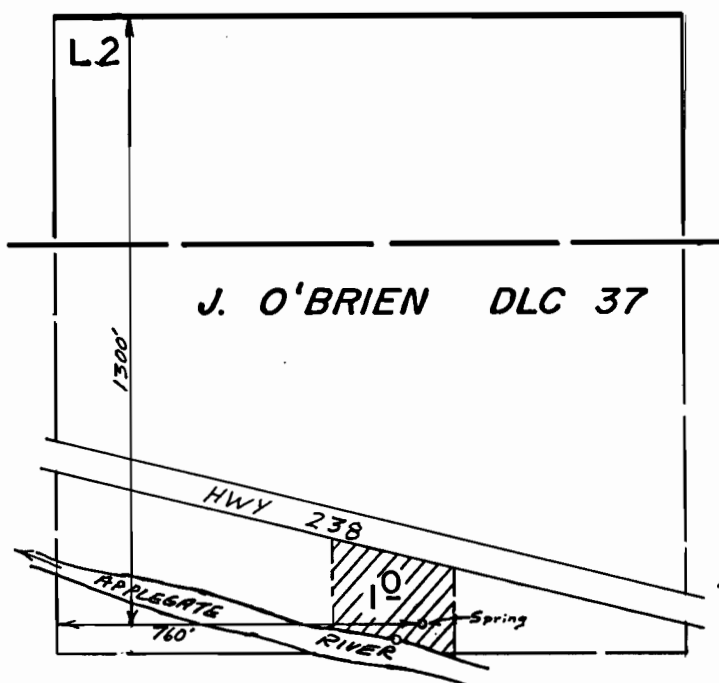

Scale 1" = 400'

FINAL PROOF SURVEY
UNDER

Application No. 65813..... Permit No. 48071.....
IN NAME OF

JACK E. DOWNS

Surveyed Aug. 22, 1985, by B.S. JAMES