


T.6 & 7 S., R.1 & 2 E.

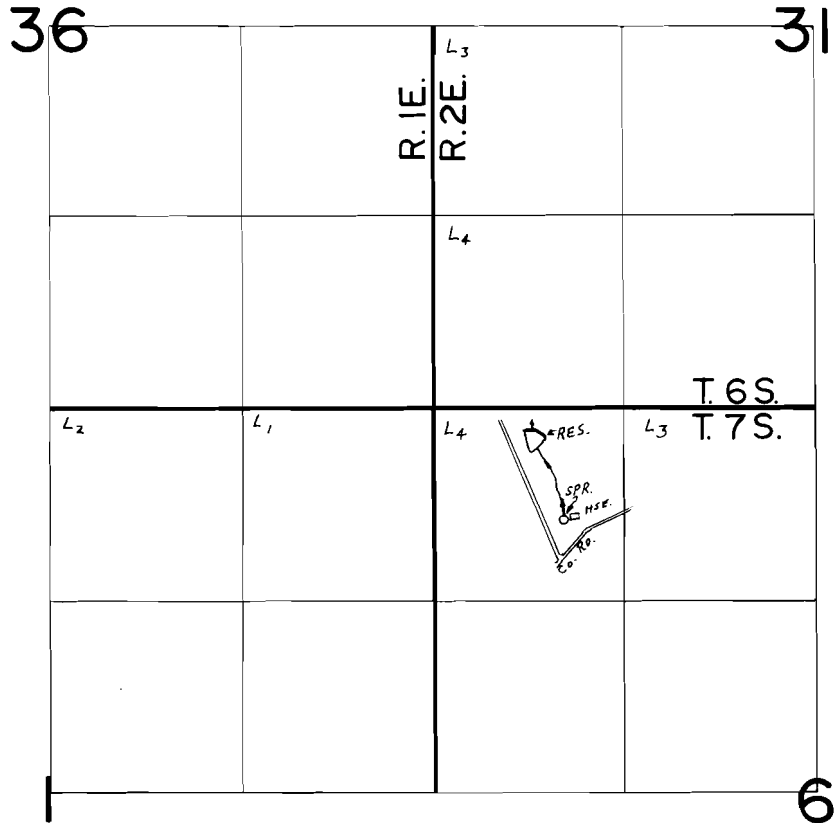

Dam Loc. : 150' S. & 650' E.

Spring Loc.: 780' S. & 890' E., both from NW Cor. Sec. 6.

Scale: 1" = 1320'

FINAL PROOF SURVEY
UNDER

R-58451

R- 7818

Application No. ~~58452~~ Permit No. ~~44093~~.....

IN NAME OF

KATHERINE YOUNG

Surveyed April 24, 1986, by T. Warren.....