


T. 28S., R. 7W., W.M.

SEC. 35

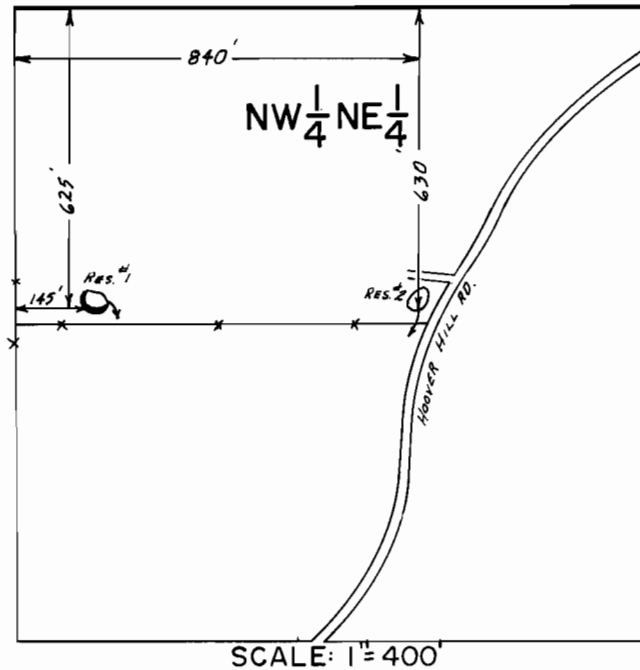

FINAL PROOF SURVEY
UNDER

Application No. R-54184 Permit No. R-6466....
IN NAME OF

.....
Surveyed JUNE 4... 1979., by J.S. DONALDSON