


T. 7S. R. 2W., W.M.

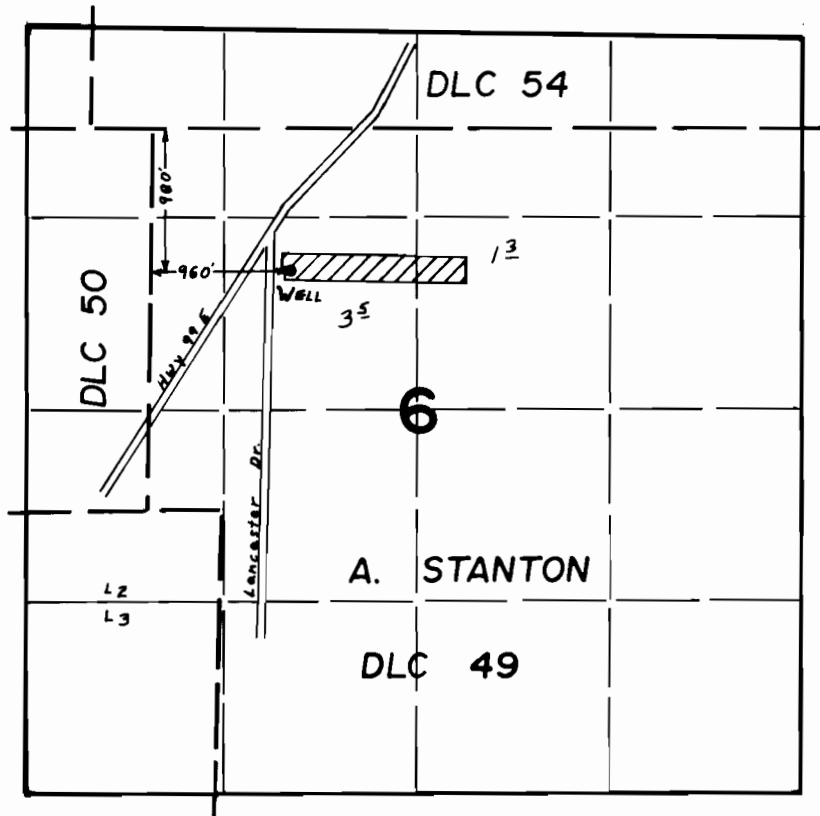

FINAL PROOF SURVEY UNDER

Application No. G-5926. Permit No. G-5633.....
IN NAME OF

..... LOUIS C. & VINA M. BEAN

Surveyed MAY 31, 1979, by L. H. NUNN.....