


T. 4 S. R. 1 W., W.M.

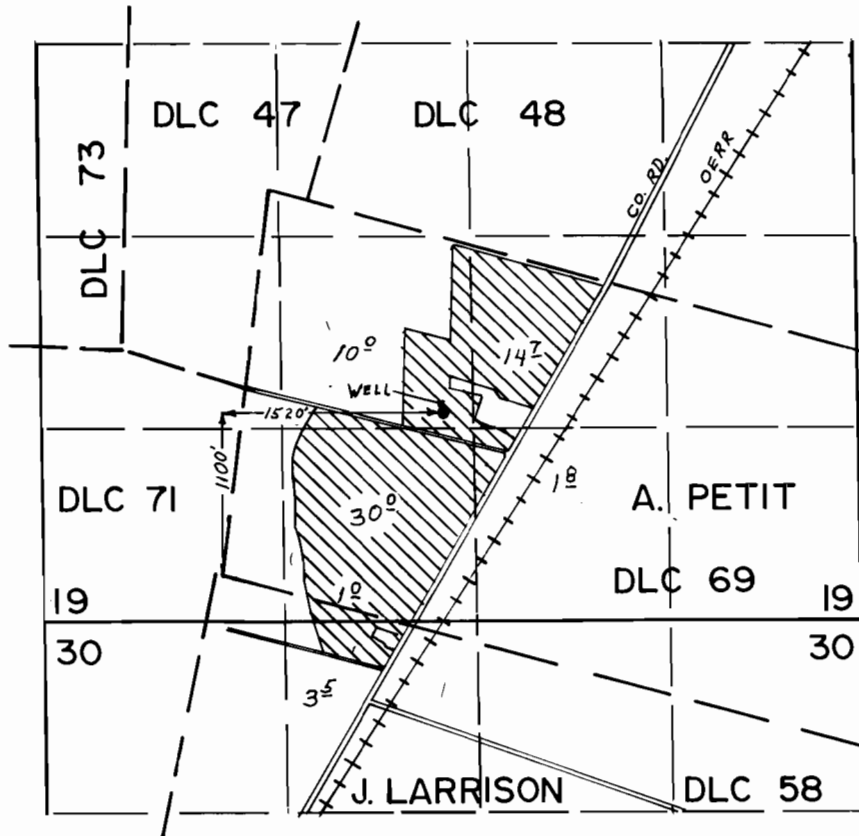

FINAL PROOF SURVEY UNDER

Application No. G-7242.. Permit No. G-6647..
IN NAME OF

.....NORBERT. H. GILLES.....

Surveyed SEP. 25. 1978., by S. P. APPLGATE.