


T.35S.,R.4W.,W.M.

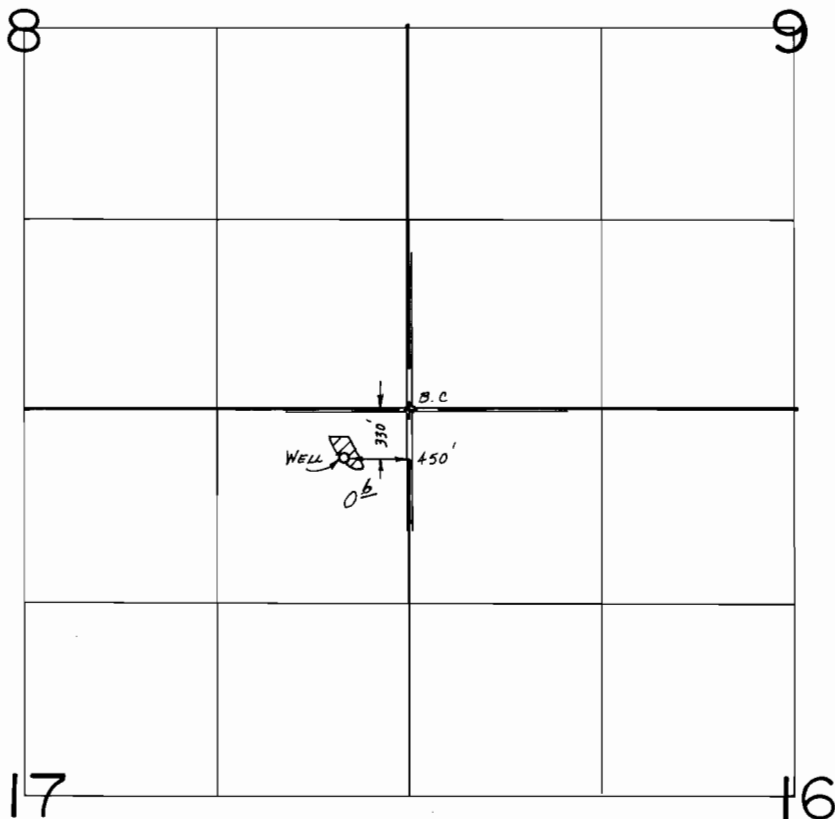

SCALE: 1" = 1320'

FINAL PROOF SURVEY
UNDERApplication No. G-7449 Permit No. G-6942....
IN NAME OF.....
Surveyed Aug. 13, 1985, by B.S. JAMES.....