# T. 35S., R. 6 W., W.M.

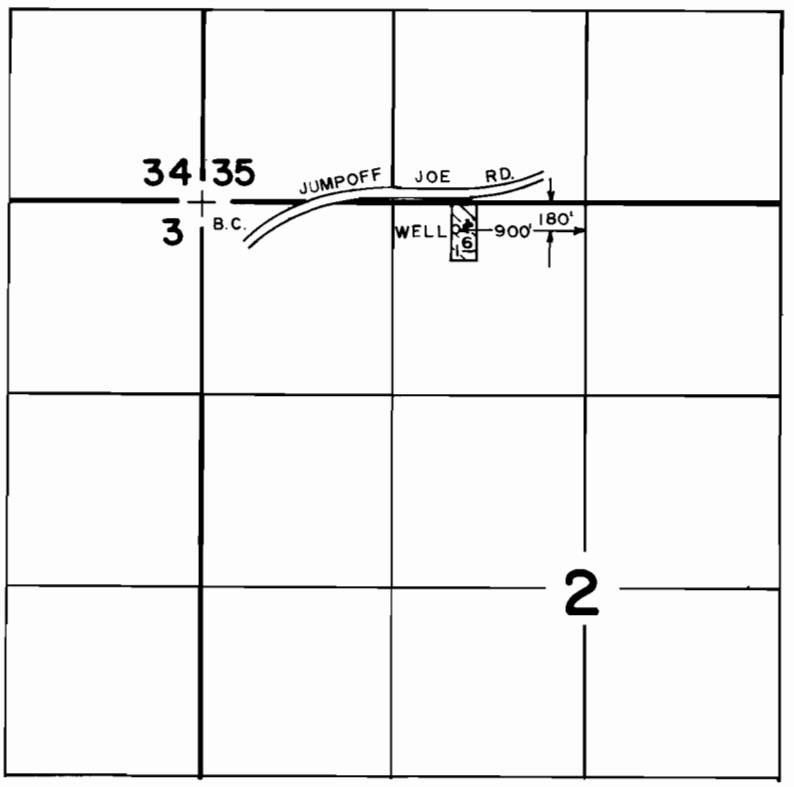


## FINAL PROOF SURVEY

UNDER

Application No. G-7548 Permit No. G-7016

IN NAME OF

RICHARD C. & JANET RUTH GILMORE

Surveyed SEPT. 15, 1982, by B. SUZIE JAMES

SCALE: 4" = 1 MILE

179-151R TWB