
T. 7S. R.2&3W. W.M.

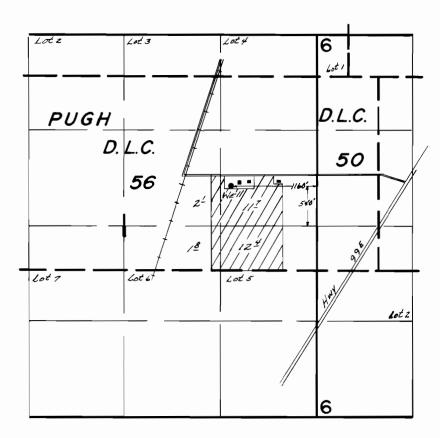

FINAL PROOF SURVEY

Application No.	G-7809 Permit No. G-7230 IN NAME OF
ESSENTIAL OILS, INC.	

Surveyed Oct. 17. 1979, by C.R.RODRIGUEZ.

DFN-611-145