


T. 4S. R. 1W.W.M.

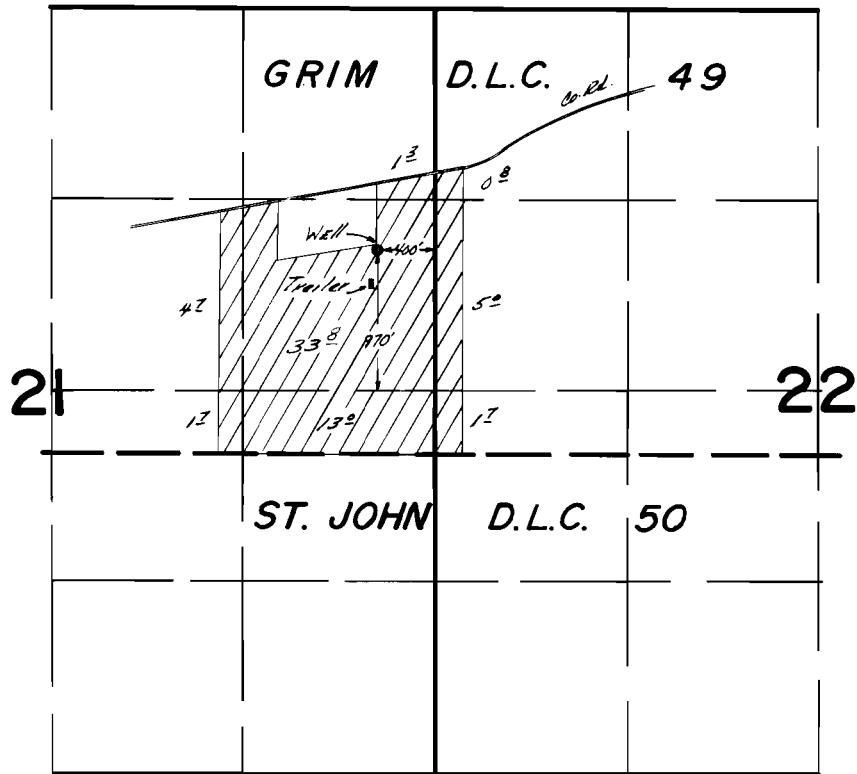

FINAL PROOF SURVEY

UNDER

Application No. G-7.679 Permit No. G-7.243...
IN NAME OF

..... RICKY C. ZACKER

Surveyed Oct. 17, 1979, by C.R. RODRIGUEZ.