T.7S. R.2W. W.M.

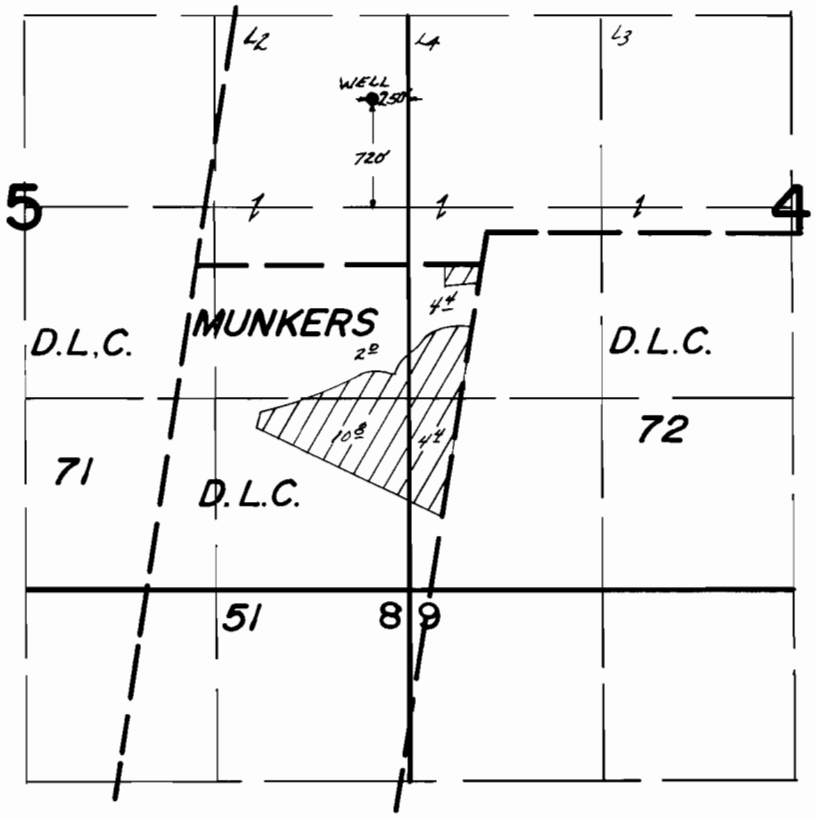

FINAL PROOF SURVEY
UNDER

Application No. G-7850 Permit No. G-7281
IN NAME OF

ALVIN SCHWENGEL

Surveyed Sept. 4 1979, by C. R. RODRIGUEZ

DFN-6LL-145