


T.39S., R.1E., W.M.

Sec. 13

NW 1/4 SE 1/4

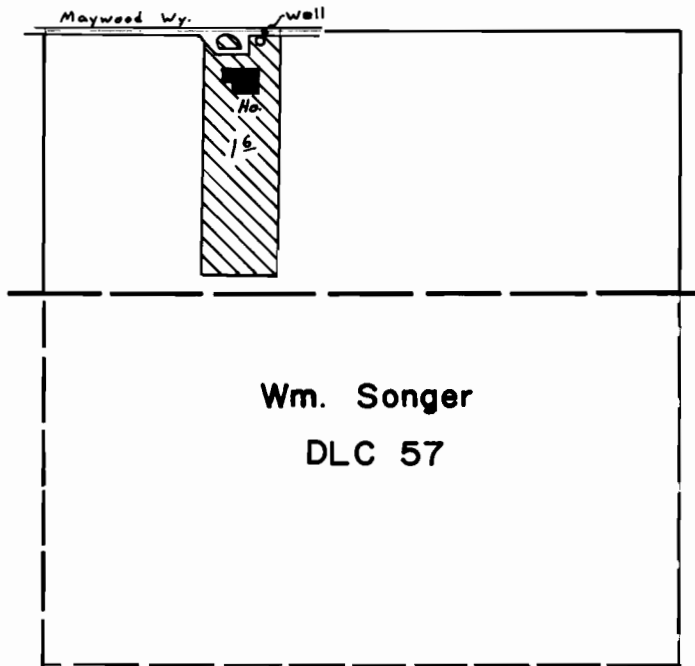

WELL: 30'S & 445'E from the Center of Sec. 13.

Scale 4" = 1 mile

SCALE 1" = 400'

FINAL PROOF SURVEY
UNDER

Application No. G-8306 Permit No. G-7708.
IN NAME OF

.....JOHN E. & LORETTA J. STUDEBAKER

Surveyed March 28, 1980, by B.R. SUND.....