


G-7840
56540
T 9813

T.26S. R.15E. W.M.

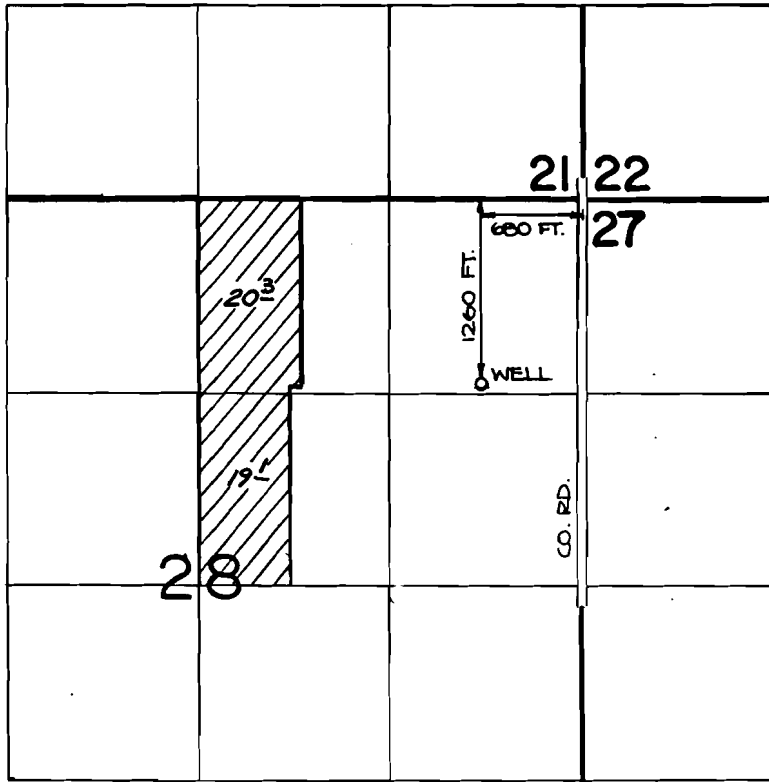

FINAL PROOF SURVEY UNDER



SCALE: 4" = 1 MILE

Application No. G-8398. Permit No. G-7840
IN NAME OF

MAURICE L. WARD & HAZEL I. WARD

Surveyed OCT. 15, 1984, by P. Patten