


T.2N. R.14 & 15E. W.M.

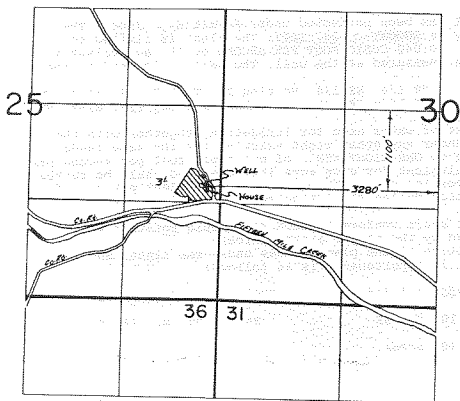

**FINAL PROOF SURVEY**  
UNDER

Application No. G-8412. Permit No. G-7904  
IN NAME OF

MAX KASEBERG

Surveyed Jan. 21, 1982, by T. Paul