


T.5S., R.1E., W.M.

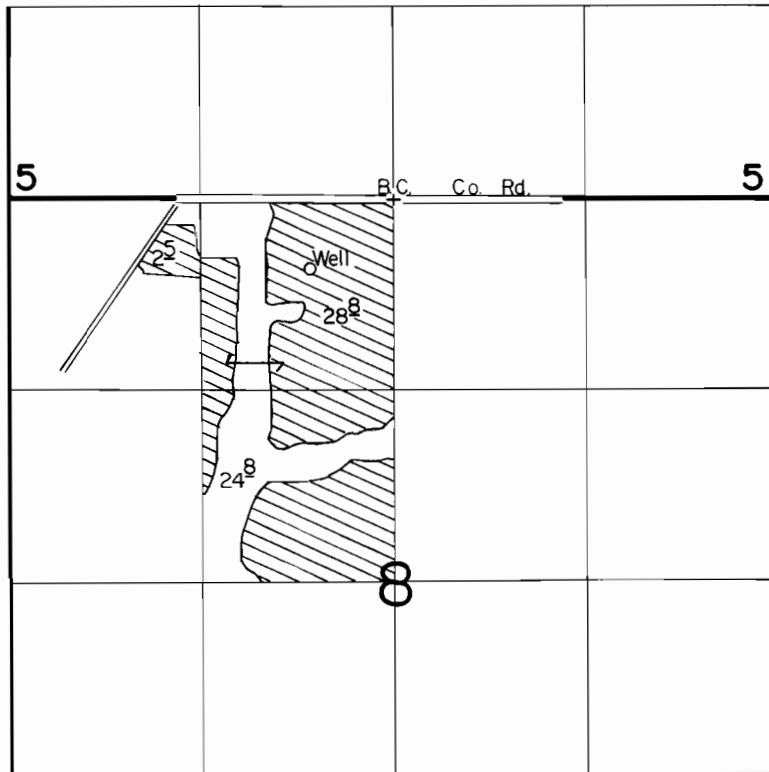

Well Loc. : 480' S. & 560' W. from N. 1/4 Cor. Sec. 8.

Scale : 1" = 1320'

FINAL PROOF SURVEY
UNDER

Application No. ~~G-8628~~ Permit No. ~~G-7946~~.....

IN NAME OF

IVAN S. KROPF

Surveyed ~~JUNE~~ 19 1985., by ~~T. Warren~~.....