T.8S.,R.1W.,W.M.

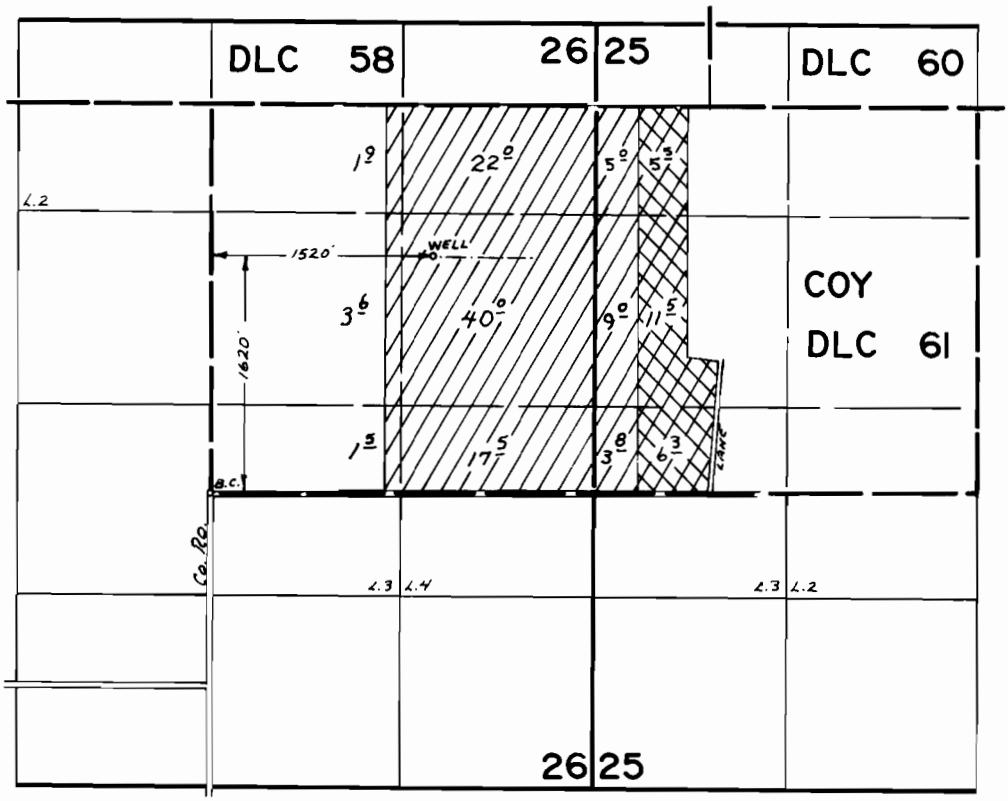

FINAL PROOF SURVEY
UNDER

Application No. G-9023 G-6131 Permit No. G-8390 G-5801

IN NAME OF

GERALD HEUBERGER

Surveyed SEPT. 10. 1976, by L. TOLL
MAY 29 1979 L. H. NUNN

DG
PTS 1976-V