


T. 26 S., R. 4 W., W.M.

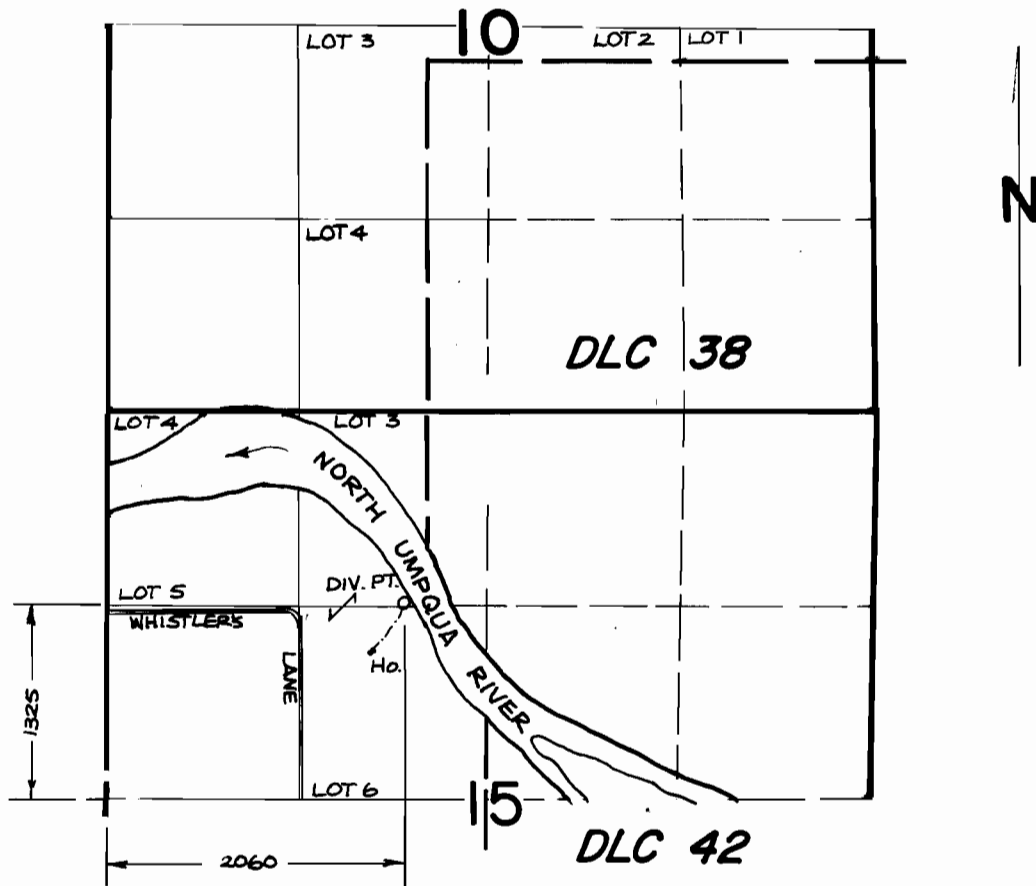

SCALE : 4" = 1 MILE

FINAL PROOF SURVEY UNDER

Application No. ...65816.. Permit No.48020...
IN NAME OF

KENNETH N. RACKLEFF & LILA RACKLEFF

Surveyed ...SEPT...3, 19.86, by ...J.M. SCHMORDE.