


T. 36 S., R. 3 W., W. M.

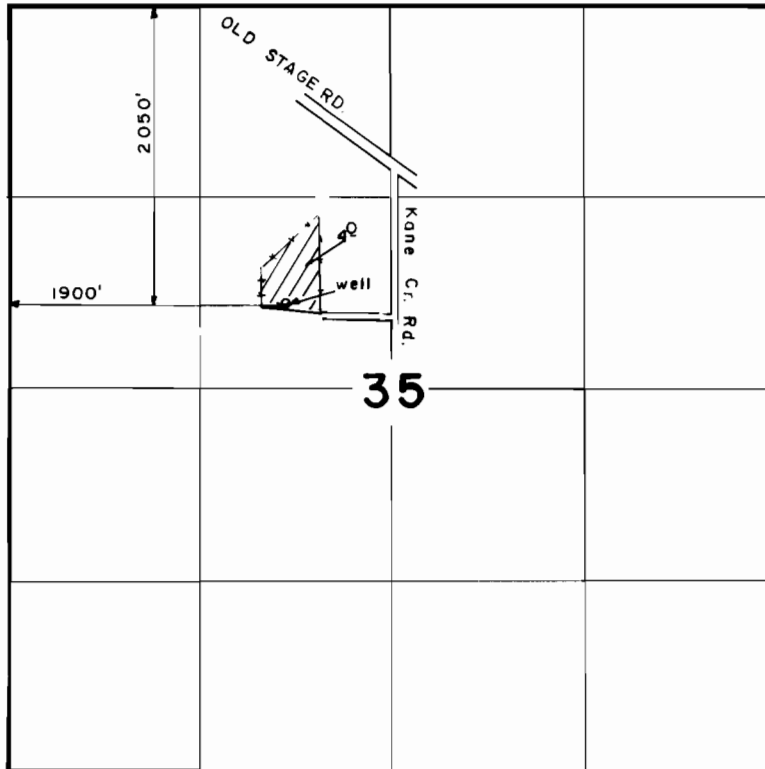

SCALE: 1" = 1320'

FINAL PROOF SURVEY
UNDER

Application No. ~~G-9885~~ Permit No. ~~G-9086~~
IN NAME OF

FRANK & DONNA SCHWAGERL

Surveyed JUN. 24. 19.86, by B.S. JAMES...