


T.30S.,R.16E.,W.M.

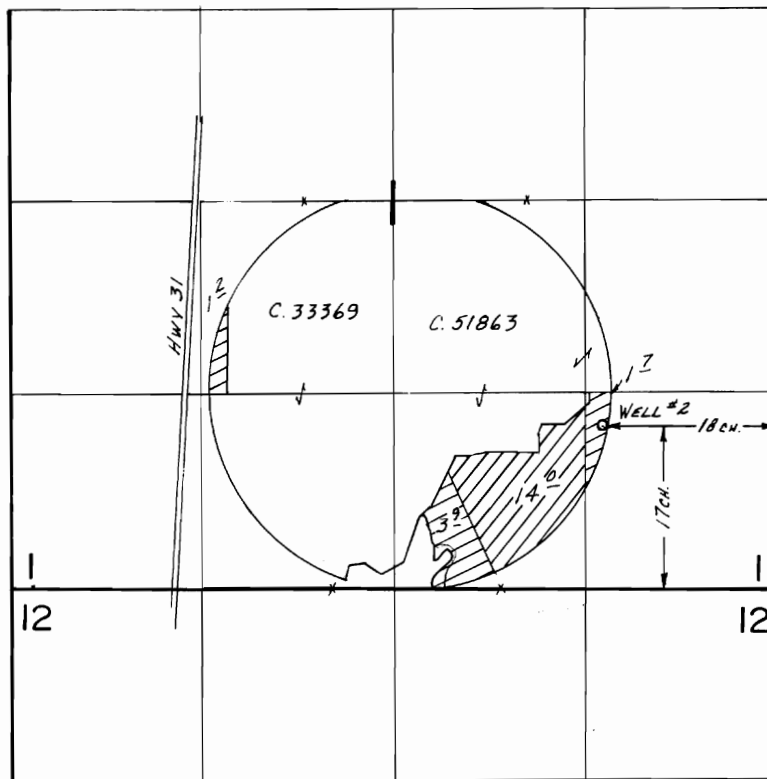

Tr. 5412
G-11199

SCALE: 1" = 1320

FINAL PROOF SURVEY **UNDER**

Transfer No. 5412
Application No. G-11199 Permit No. G-10293...
IN NAME OF

.....WITHERS RANCH, INC.

Surveyed Oct. 14... 1985, by B.W. BISHOP.....