


T. 7 S., R. 1 W., W.M.

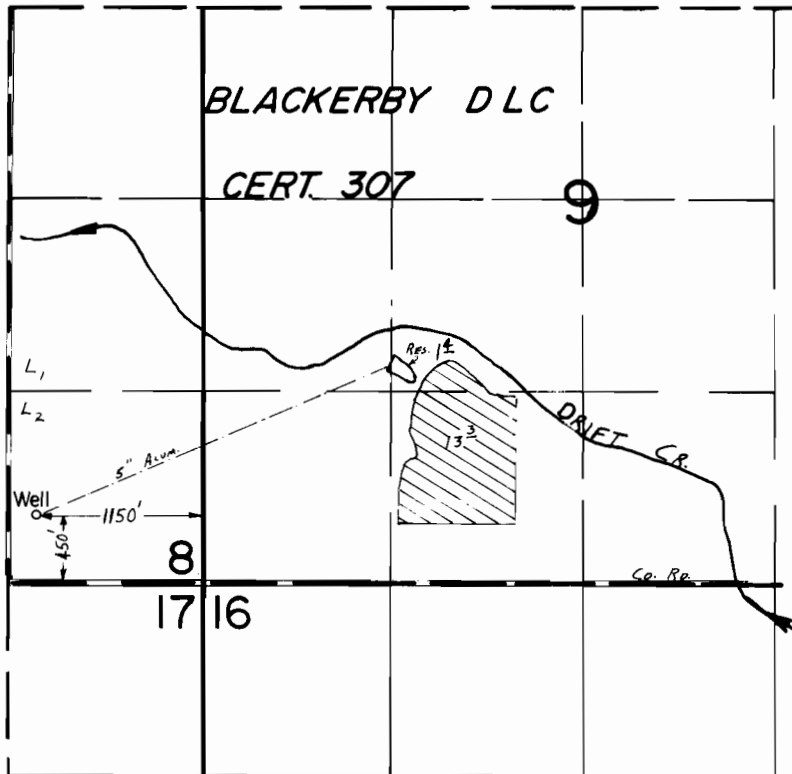

Scale: 1" = 1320'

FINAL PROOF SURVEY
UNDER

Application No. G-11434.. Permit No. G-10533....
IN NAME OF

BEN KAUFMAN

Surveyed April...21, 1986., by T. Warren.....