


T.16S.,R.42E.,W.M.

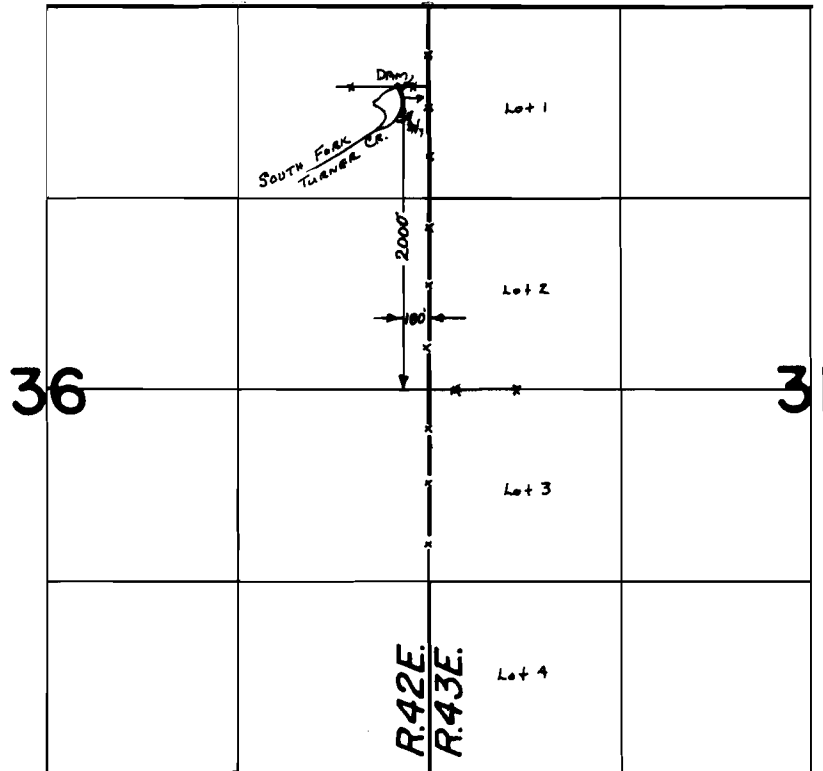

SCALE: 1"=1320'

FINAL PROOF SURVEY
UNDER

Application No. R-57044 Permit No. R-7677.....
IN NAME OF

.....C. H. MUNSTERMAN.....

Surveyed Oct....8.... 1985, by L. M. TOLL.....