
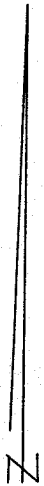


P-29510
56557

T. 17S., R. 28E., W. M.

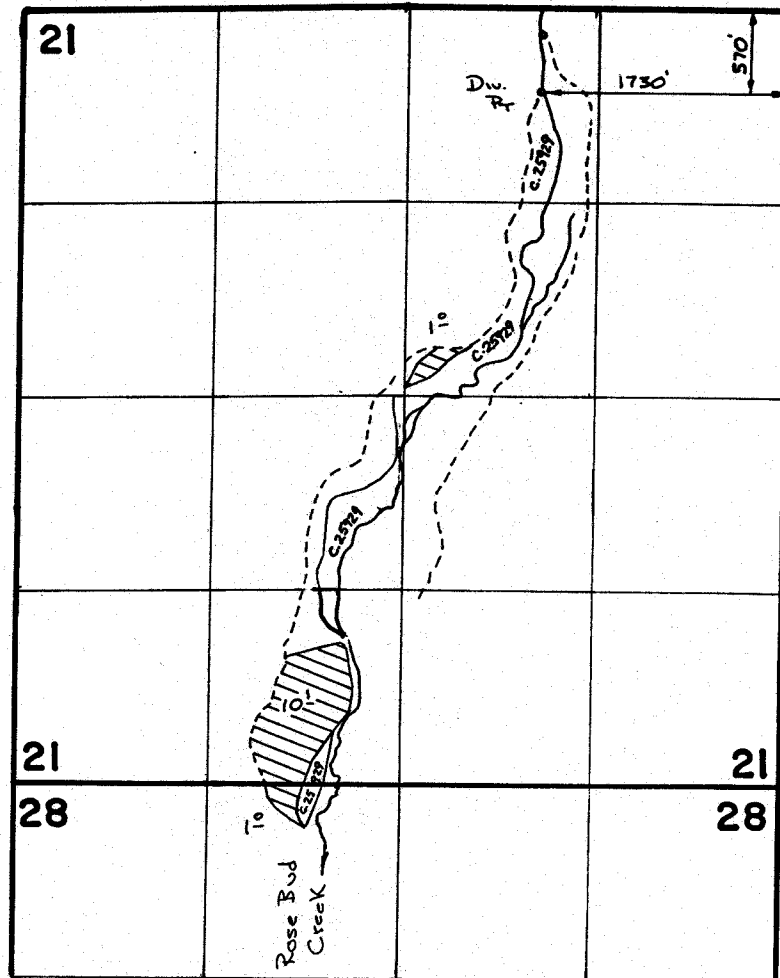

SCALE: 1" = 1320'

FINAL PROOF SURVEY UNDER

Application No. **39407** Permit No. **29510**....
IN NAME OF

CHARLES JACK & MIRIAM JANE ST. CLAIR

Surveyed **4-23**..... 198**4**., by **h. Toll**.....