


T. 10S. R. 34E. W.M.

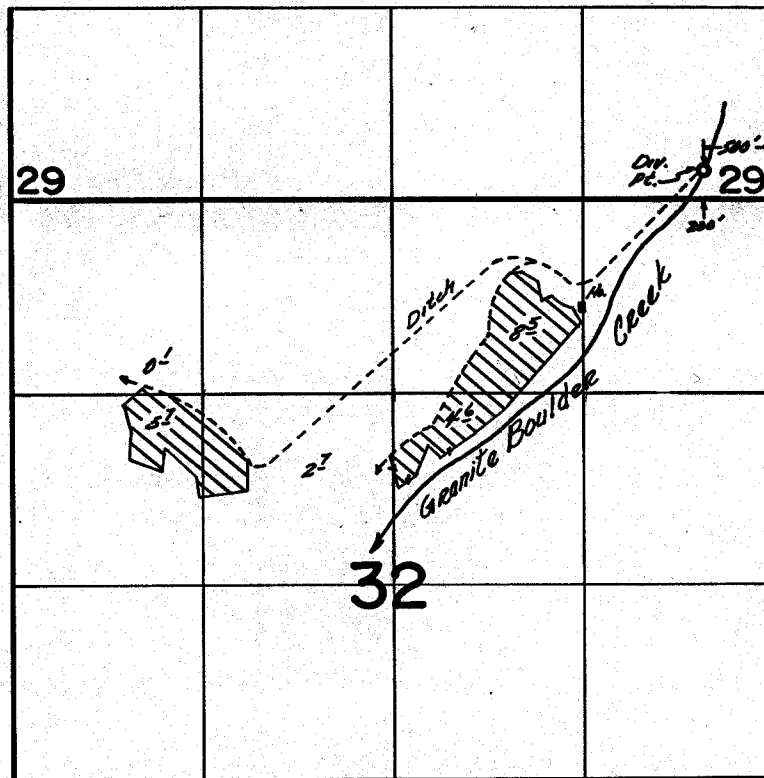

FINAL PROOF SURVEY
UNDER

Application No. 43266. Permit No. 32340.....
IN NAME OF

.....
OXBOW RANCH
.....

Surveyed July..14.. 1979., by S.C.BROWN.....