


T.21S. R.3E. W.M.

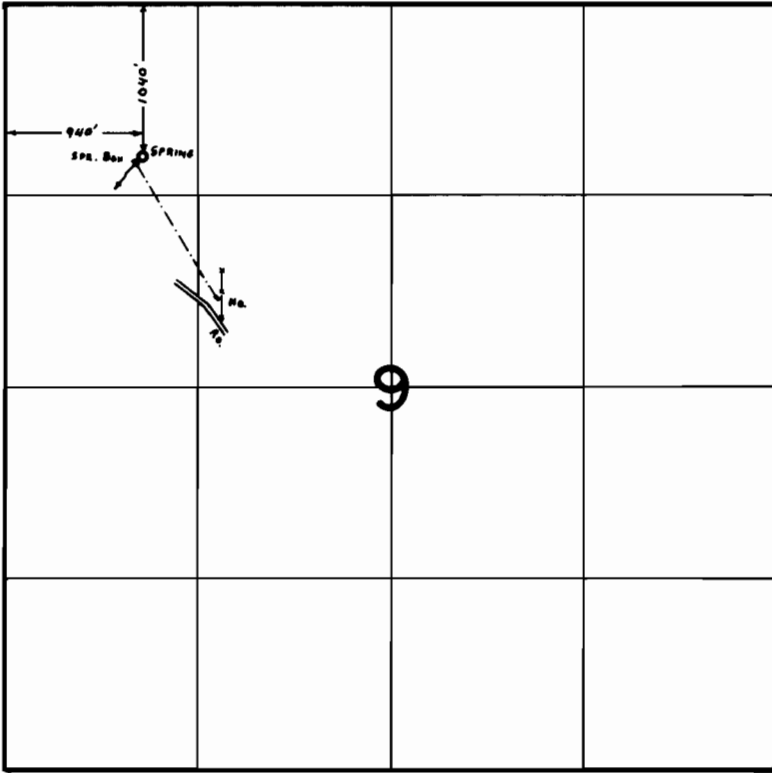

FINAL PROOF SURVEY UNDER

Application No. ~~46842~~ Permit No. ~~35027~~.....
IN NAME OF

.....LEWIS R. COYLE.....

Surveyed May 25, 1979, by C. L. HUGHES.....