


T.36 S., R.3 W., W.M.

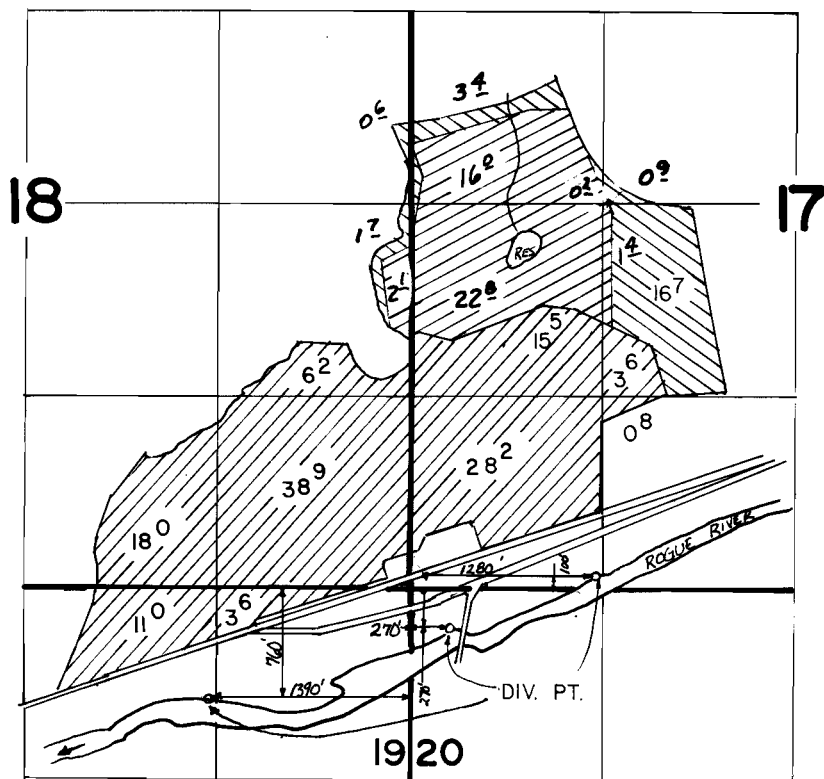

1" = 1320'

FINAL PROOF SURVEY UNDER

Application No. 47103 Permit No. 35270 
 47104 35271  supp.  primary
 IN NAME OF

DEL RIO ORCHARDS

Surveyed MARCH 30 1982, by .B.R..SUND.....