


T. 3S., R. 40E., W. M.

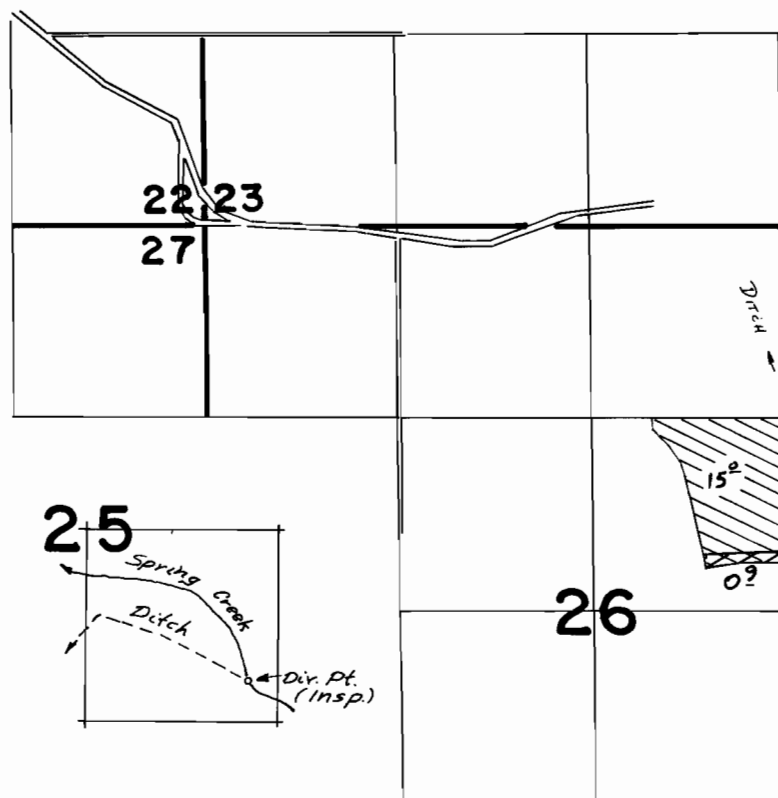

Dir. Pt. Loc: 280' N. & 200' W. from ctr.
of SE 1/4, Sec. 25

 Towle
 Hart

FINAL PROOF SURVEY

UNDER

Application No. 48197 Permit No. 36202

IN NAME OF

Steven I. and Lynn G. Hart

.....Clifford and Ardith Towle.....

Surveyed Sept. 24 1976, by D. M. Norby
April 16, 1987 V. L. Church