


T. 1S. R. 38E. W.M.

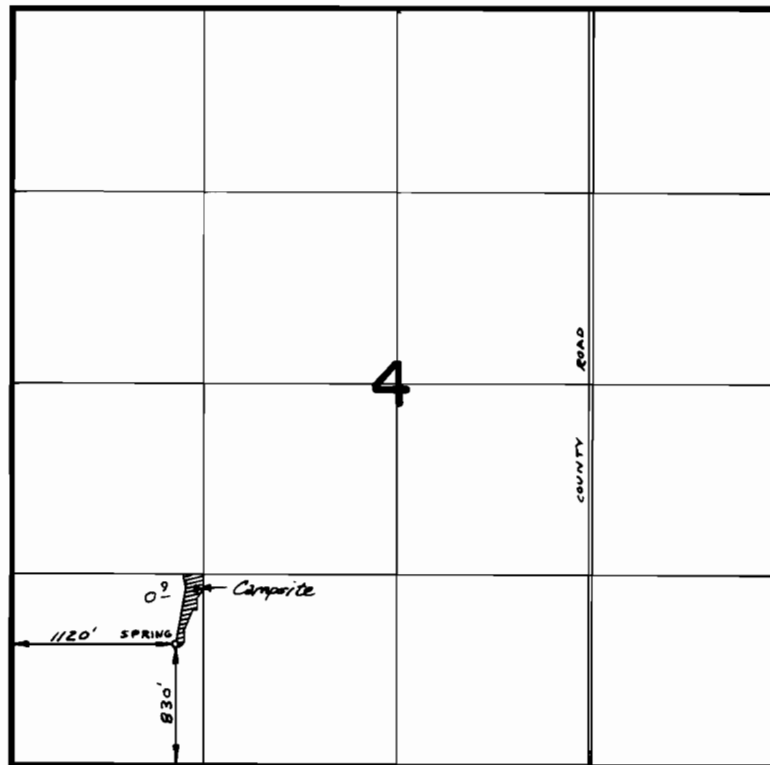

FINAL PROOF SURVEY
UNDER

Application No. 48774 Permit No. 36573
IN NAME OF

RALPH H. LONG

Surveyed 6-28 1978, by R. BARWIN